

21,000 N

21,000 N

18,000 N

18,000 N


15,000 N

15,000 N


17,000 E

20,000 E

25,000 E

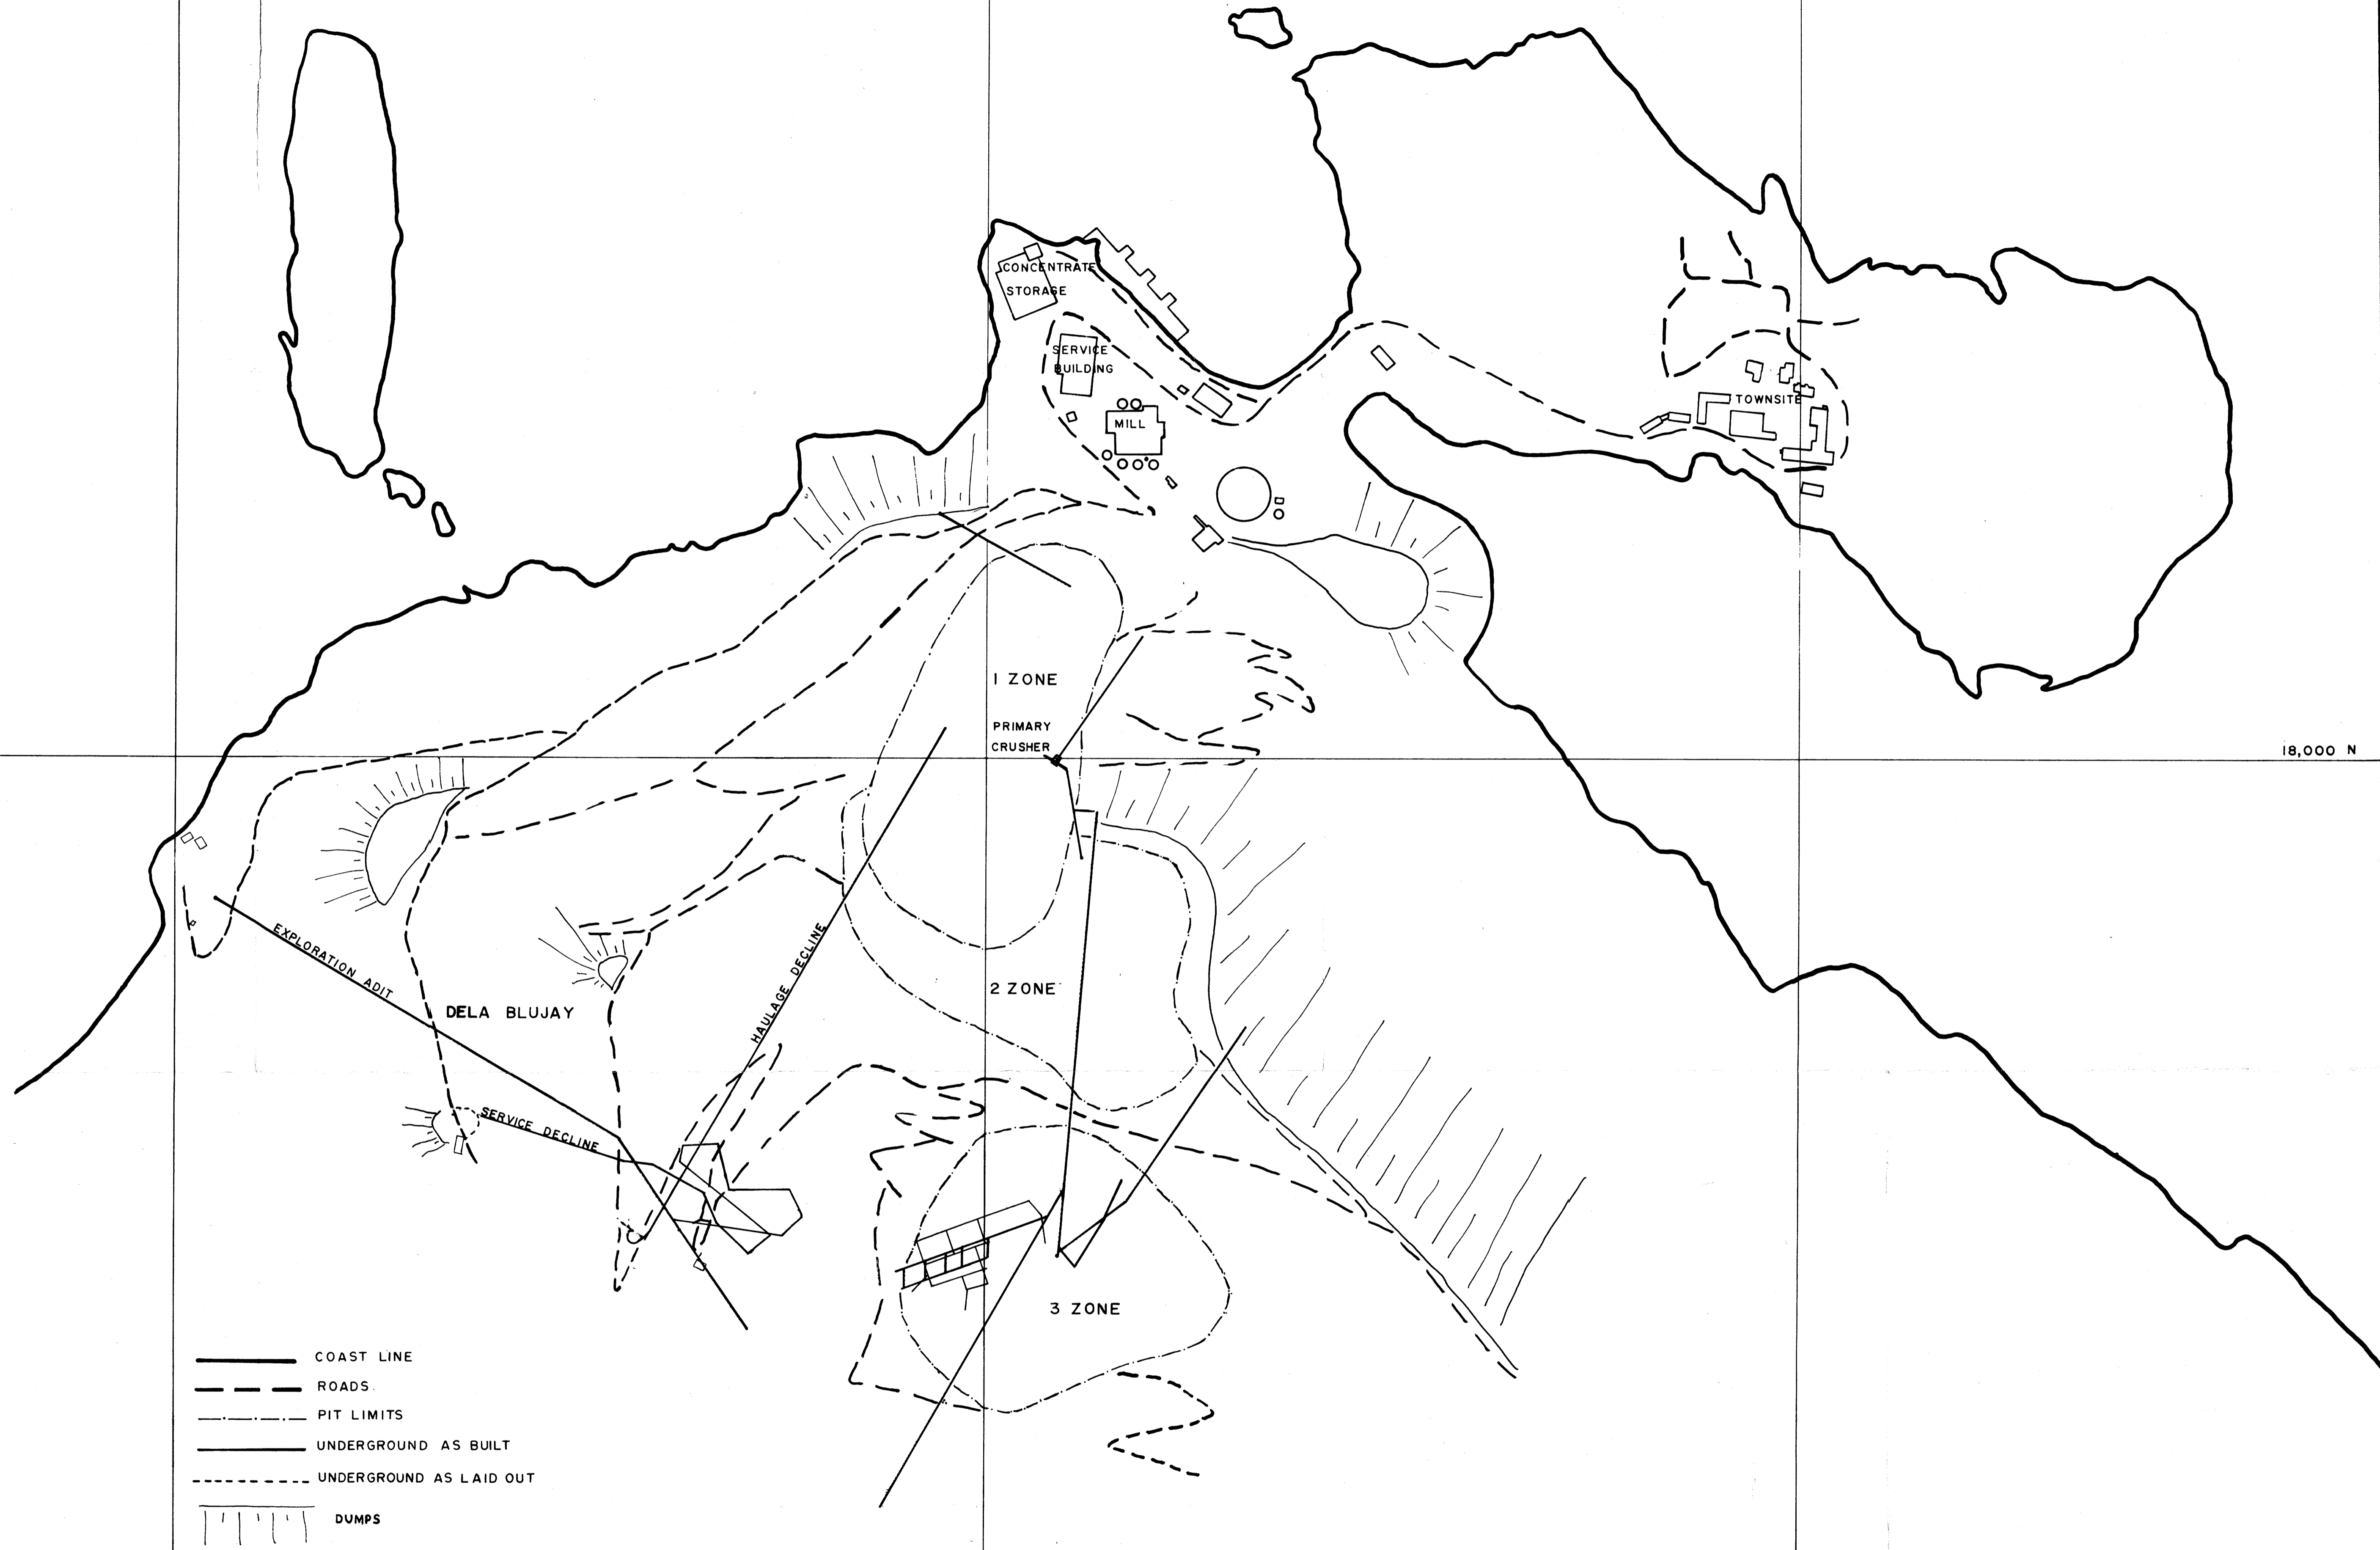

- COAST LINE
- - - ROADS
- - - - PIT LIMITS
- UNDERGROUND AS BUILT
- - - - UNDERGROUND AS LAID OUT
- | | | | DUMPS

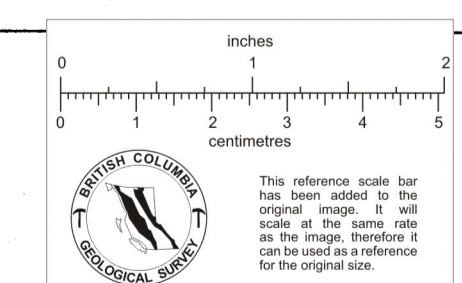

WESFROB MINES LIMITED - TASU, B.C.		
<b>AREA PLAN</b>		
SCALE: 1"=300'	DATE:	NO. 500-012