

675819  
Robb Lake  
94B/13

This is incomplete report on Ric Property  
COMINCO LTD  
near heatwaters of RICHARDS CREEK

DRAFT

INTRODUCTION

The Ric property is located in the Main Ranges of the Northern Rocky Mountains. The claims straddle part of a north-north-west trending belt of lower and middle Paleozoic miogeoclinal carbonate rocks, quartzites, siltstones and shales which are exposed in a series of folded thrust panels that have undergone northeasterly directed tectonic transport. Several zinc and lead showings occur in the upper part of the Stone Formation, a thick dolomite of middle Devonian age.

STRATIGRAPHY

A thick succession of carbonate and ~~epiclastic~~ rocks of Cambro-Ordovician, Silurian and Devonian ages crop out on the claim area. An attempt was made to keep major stratigraphic subdivisions consistent with those of Taylor and Stott (1973) in the Tuchodi Lakes Map-Area north of Richards Creek, however no distinction was made between the Cambrian (Atan Group) and the Ordovician (Kechika Group), and the basal Devonian Munch-McConnell Formation was not recognized, and the Wakkpash Formation was included with the Lower Devonian Stone Formation. The Cambro-Ordovician succession is divided into four

lithologically distinct units (refer to figures ..... and .....).

The lowest unit ( $EO_{rls}$ ) is composed of tan weathering ribbed limestone. Within this unit is a thin distinctive light grey micritic limestone marker ( $EO_{mls}$ ). A recessive, brown weathering, bioturbated silty dolomite ( $EO_{bd}$ ) separates the ribbed limestones from the upper unit of cliff-forming grey dolomite with sandstone interbeds ( $EO_d$ ).

The ribbed limestone unit consists of interbedded and interlaminated grey limestone (and dolomitic limestone) and tan weathering dolomitic siltstone and sandstone. Many beds contain small-scale crossbeds, ripple laminations and load features. Beds, a few feet thick, of massive light-grey weathering fine grained dolomite laced with hairline subvertical fractures filled with white sparry dolomite are common in the lower part of the unit. The micritic limestone marker unit is approximately 150 feet thick and contains numerous stylolites parallel to bedding. The bioturbated silty dolomite is approximately 300 feet thick and is conspicuous because of its recessive weathering nature. It is thin bedded to laminated, and cross bedding is present throughout. The upper dolomite unit is

lithologically variable. Massive fine crystalline grey dolomite is interbedded with cross stratified dolomitic sandstone and siltstone, thin orthoquartzites, and a distinctive pisolite bed. Scour and fill features, mudcracks, burrows and ripple laminations are common <sup>in</sup> ~~ka~~ most sandy beds.

The Silurian Nonda Formation (Sn) consists of medium grey dolomite and dolomitic sandstone with a white 30 foot thick orthoquartzite marker bed (Sn<sub>q</sub>) at its base. Fossiliferous beds from which Halysites sp., Syringopora sp., Favosites sp., Synaptaphylum sp. and Horn corals were identified, occur throughout the section. Upper part of the succession is medium to dark grey and thin-bedded with thin argillite interbeds; this may belong to the Devonian Muncho-McConnell Formation which was not recognized in the field.

A conspicuous change in colouration from medium to light grey was used to distinguish between the Silurian and the Devonian successions. This corresponds with a change in lithology from the darker thin bedded dolomites to light blocky dolomitic sandstone, and sandy dolomite with thin orthoquartzite beds. These lithologies grade discontinuously upward into massive beds of fine and medium crystalline dolomite with sandy intervals.

How ABOUT  
ORTHOQUARTZITE MEMBER  
IN MIDDLE OF UNIT?



This thick succession of dolomites was mapped as the Stone Formation, <sup>(D<sub>s</sub>)</sup> including the basal dolomitic sandstones and orthoquartzites which probably belong to the Wokkash Formation (Taylor, 19\_\_\_). Upper part of the Stone Formation consists of blocky fine crystalline dolomite with thin interbeds of micritic limestone near its upper contact. Some beds are finely laminated with apparent stromatolitic structures. Vugs filled with coarse sparry dolomite and quartz are common in some beds.

Overlying the Stone Formation are light to medium grey micritic limestones of the middle Devonian Dunedin Formation. <sup>(D<sub>d</sub>)</sup>

The Formation comprises at least several hundred feet (a <sup>locally?</sup> complete section is not preserved) of laminated micritic limestone, oolitic limestone and occasional interbeds of bioturbated micritic limestone.

The Besa River Formation <sup>(D<sub>br</sub>)</sup> is a recessive, black moderately fissile shale which overlies the Dunedin fault contact with the Stone and Dunedin Formations. <sup>formation is in ?</sup>

#### STRUCTURE

Structure of the Richards Creek area is shown in figure .....  
a structure cross section of the map area. Folding and thrust faulting dominate the structural style and have had the effect of

repeating the stratigraphy. The Devonian carbonate units have responded as broadly folded competent thrust panels whereas the less competent and lithologically more variable Cambro-Ordovician and Silurian rocks and the Besa River shale have been intricately folded at the meso<sup>S</sup>scopic and regional scales into tight northeasterly overturned folds, often with ruptured axial planes. The Cambro-Ordovician forms a large recumbent, near<sup>ly</sup> isoclinal nappe in the western portion of the map area (see figure) (.....) with its lower limb truncated by the thrust fault shown in figure (...). Adjacent to the anticline is an upright broad syncline with the Stone and Dunedin Formations in its core.

**Mineralization:**

The lead-zinc occurrences are confined to the upper part of the Stone Formation and lower part of the Dunedin Formation. Fourteen occurrences are known to date which are divided between separate thrust panels of the Stone and Dunedin Formations. Two showings have received considerable examination: the "Bunker Creek showing" is<sup>in</sup> the lower thrust panel approximately one hundred feet stratigraphically below the Stone-Dunedin contact; the "upper showing" is situated in the overlying



thrust panel in and adjacent to Richards Creek. Sixteen diamond drill holes with ~~a total footage of~~ <sup>totaling</sup> 3,381 feet were drilled in the summers of 1972 and 197<sup>3</sup>, five into the 'Bunker Creek Showing' and 11 into the 'upper showing'.

Pyrite, marcasite, sphalerite and galena are the sulphide minerals present. They occur as irregular massive pods, along fractures, and associated with white sparite and quartz filled cavities. The massive mineralization (see figure ....) normally constitutes a fine grained mixture of pyrite and marcasite containing irregular patches, blebs and fractures <sup>fillings</sup> of later coarser-grained sphalerite. Remnants of dolomite with diffuse boundaries and containing fine pyrite and marcasite suggest replacement by the latter. The fracture fillings (figure ....) tend to be perpendicular to or parallel to bedding, but may coalesce into irregular networks of veins containing fragments of dolomite. Coarse grained sphalerite is most common with some patches of fine pyrite and marcasite which appear to have replaced original dolomite. The cavity fillings are spacially related to the fractures and are filled with very coarse sparry dolomite and quartz, sphalerite pyrite and marcasite. Galena <sup>does</sup> occur in most showings but only as a minor constituent. <sup>Fract.</sup> Coarse dolomite breccias (figure <sup>(Fig. -)</sup> ....)

typical of the Robb Lake area are present in the Stone  
Formation <sup>(Figure)</sup> but they do not appear to be important <sup>with</sup> with  
regard to lead-zinc mineralization. At present there is no  
obvious explanation for the distribution of showings.  
Fractures appear to have provided the necessary permeability  
for migration of metal bearing fluids.

GREAT AS FAR AS IT GOES BUT  
WHO DID THE WORK, OWNS THE PROPERTY ETC  
HOW DO YOU REGARD THE SHOWINGS - SIGNIFICANT  
- INTERESTING INDICATORS OF OTHER POSSIBILITIES, INSIGNIFICANT

GOOD PHOTOS





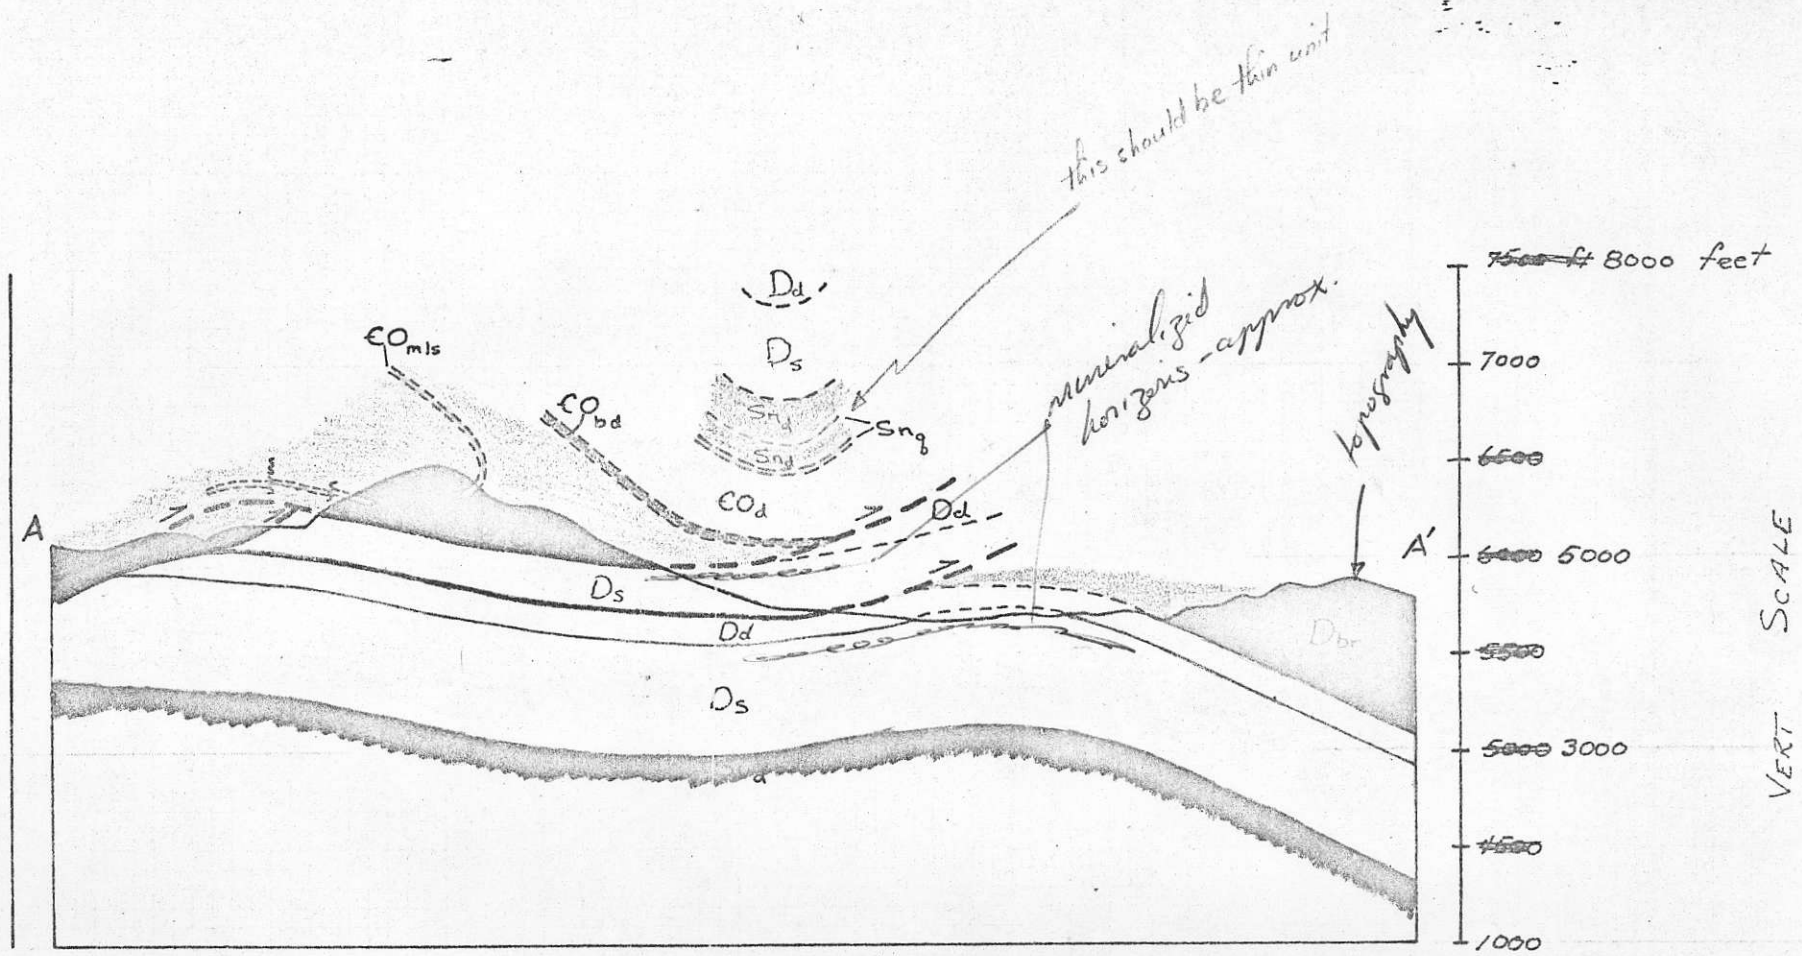


Figure : Structure cross section of the Richards Creek area

HORIZONTAL SCALE



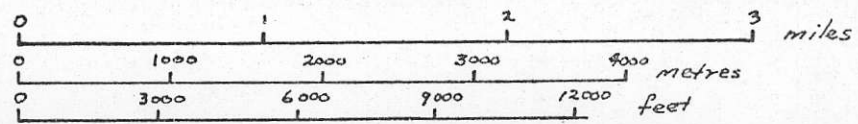

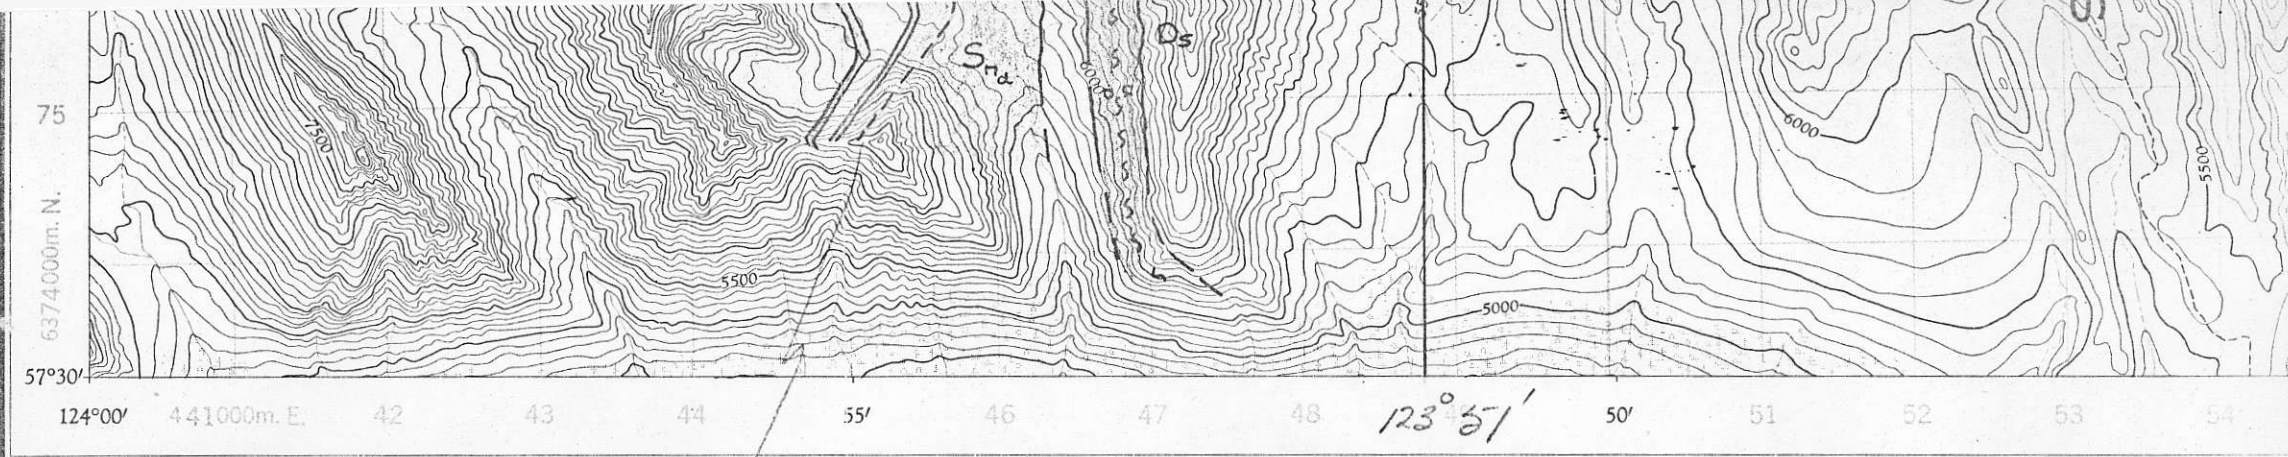

Compiled, 1963, by the SURVEYS AND MAPPING BRANCH,  
DEPARTMENT OF MINES AND TECHNICAL SURVEYS,  
from aerial photographs taken in 1960. Field surveys 1958.  
Printed 1966.

Copies may be obtained from the Map Distribution Office,  
Department of Mines and Technical Surveys, Ottawa.

(Joins Redfern Lake 94G/5W)

# RICHARDS CREEK


PEACE RIVER DISTRICT 94G-12W  
BRITISH COLUMBIA

Rédigée en 1963, par la DIRECTION DES LEVÉS ET DE  
MINISTÈRE DES MINES ET DES RELEVÉS TECHNIQUES  
graphiques aériennes prises en 1960. Levés sur le terrain en 1958.

Ces cartes sont en vente au Bureau de distribution des cartes  
ministère des Mines et des Relevés techniques, Ottawa.

*this should be a  
double line to represent  
rock unit but very  
thin.*

SCALE 1:50,000 ÉCHELLE

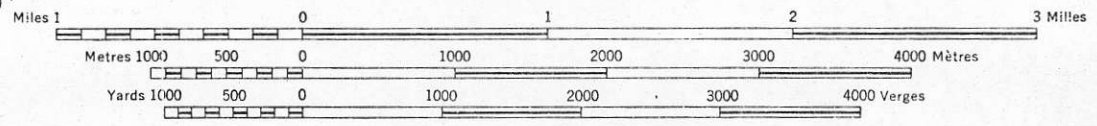

Routes:

.....	toute saison	—————
.....	période sèche	—————
.....	de terre	-----
.....	sentier ou portage	-----
.....	ge, single track	Chemin de fer, voie unique (écartement normal)
.....	line	Ligne de transport d'énergie
.....	Point, with elevation	Point géodésique avec cote
.....	elevation	Repère de nivellement avec cote


CONTOUR INTERVAL 100 FEET  
Elevations in Feet above Mean Sea Level  
North American Datum 1927  
Transverse Mercator Projection

ÉQUIDISTANCE DES COURBES 100 PIEDS  
Élévations en pieds au-dessus du niveau moyen de la mer  
Réseau géodésique nord-américain unifié (1927)  
Projection transverse de Mercator

.....	Building	.....	Bâtiment
.....	School	.....	École
.....	Church	.....	Église
.....	Lighthouse	.....	Phare
.....	River with bridge	.....	Rivière avec pont
.....	Stream, intermittent or dry	.....	Cours d'eau intermittent
.....	Lake intermittent, indefinite	.....	Lac intermittent, rive im
.....	Marsh or Swamp	.....	Marais ou marécage
.....	Depression contours	.....	Courbes de cuvette

- 936 Dbr Besa River Fm
- Dd Dunedin Fm
- Ds Stone Fm
- 945 Snd Grey & tan dolomite and sandy dolomite
- 915 Sng Ortho quartzite

- 934 EO<sub>d</sub> grey & tan dolomite
- 946 EO<sub>d</sub> bioturbated silty dolomite
- 902 EO<sub>mls</sub> micritic l.s.
- 932 EO<sub>rls</sub> ribbed silty l.s.

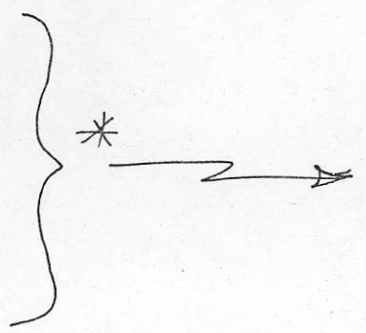

NB lettering of units is as follows:

- Dbr EO<sub>mls</sub>
- Dd EO<sub>mls</sub>
- Ds EO<sub>rls</sub>
- Snd
- Sng
- EO<sub>d</sub>
- EO<sub>bd</sub>

SYSTÈME NATIONAL

FIGURE : Geologic map of Richards Creek Area.





*Black dots denote showings*

*this should be a double line to represent rock unit but very thin.*

(Joins Redfern Lake 94G/5W)

# RICHARDS CREEK

PEACE RIVER DISTRICT  
BRITISH COLUMBIA


94G-12

SCALE 1:50,000 ÉCHELLE

Compiled, 1963, by the SURVEYS AND MAPPING BRANCH,  
DEPARTMENT OF MINES AND TECHNICAL SURVEYS,  
from aerial photographs taken in 1960. Field surveys 1958.  
Printed 1966.

Copies may be obtained from the Map Distribution Office,  
Department of Mines and Technical Surveys, Ottawa.


- Routes:
- ..... toute saison
  - ..... période sèche
  - ..... de terre
  - ..... sentier ou portage
  - ..... Chemin de fer, voie unique (écartement normal)
  - ..... Ligne de transport d'énergie
  - ..... Mine ou fosse à ciel ouvert
  - ..... Point géodésique avec cote
  - ..... Repère de nivellement avec cote

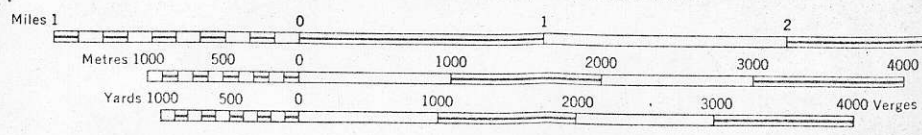

CONTOUR INTERVAL 100 FEET  
Elevations in Feet above Mean Sea Level  
North American Datum 1927  
Transverse Mercator Projection


ÉQUIDISTANCE DES COURBES 100 PIEDS  
Élévations en pieds au-dessus du niveau moyen de la  
Réseau géodésique nord-américain unifié (1927)  
Projection transverse de Mercator

- 936 Dbr Besa River Fm
- Dd Dunedin Fm
- Ds Stone Fm
- 946 EO<sub>d</sub> grey & tan dolomite
- EO<sub>s</sub> bioturbated silty dolomite
- EO<sub>ms</sub> micritic ls

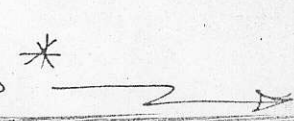



# Location map of showings

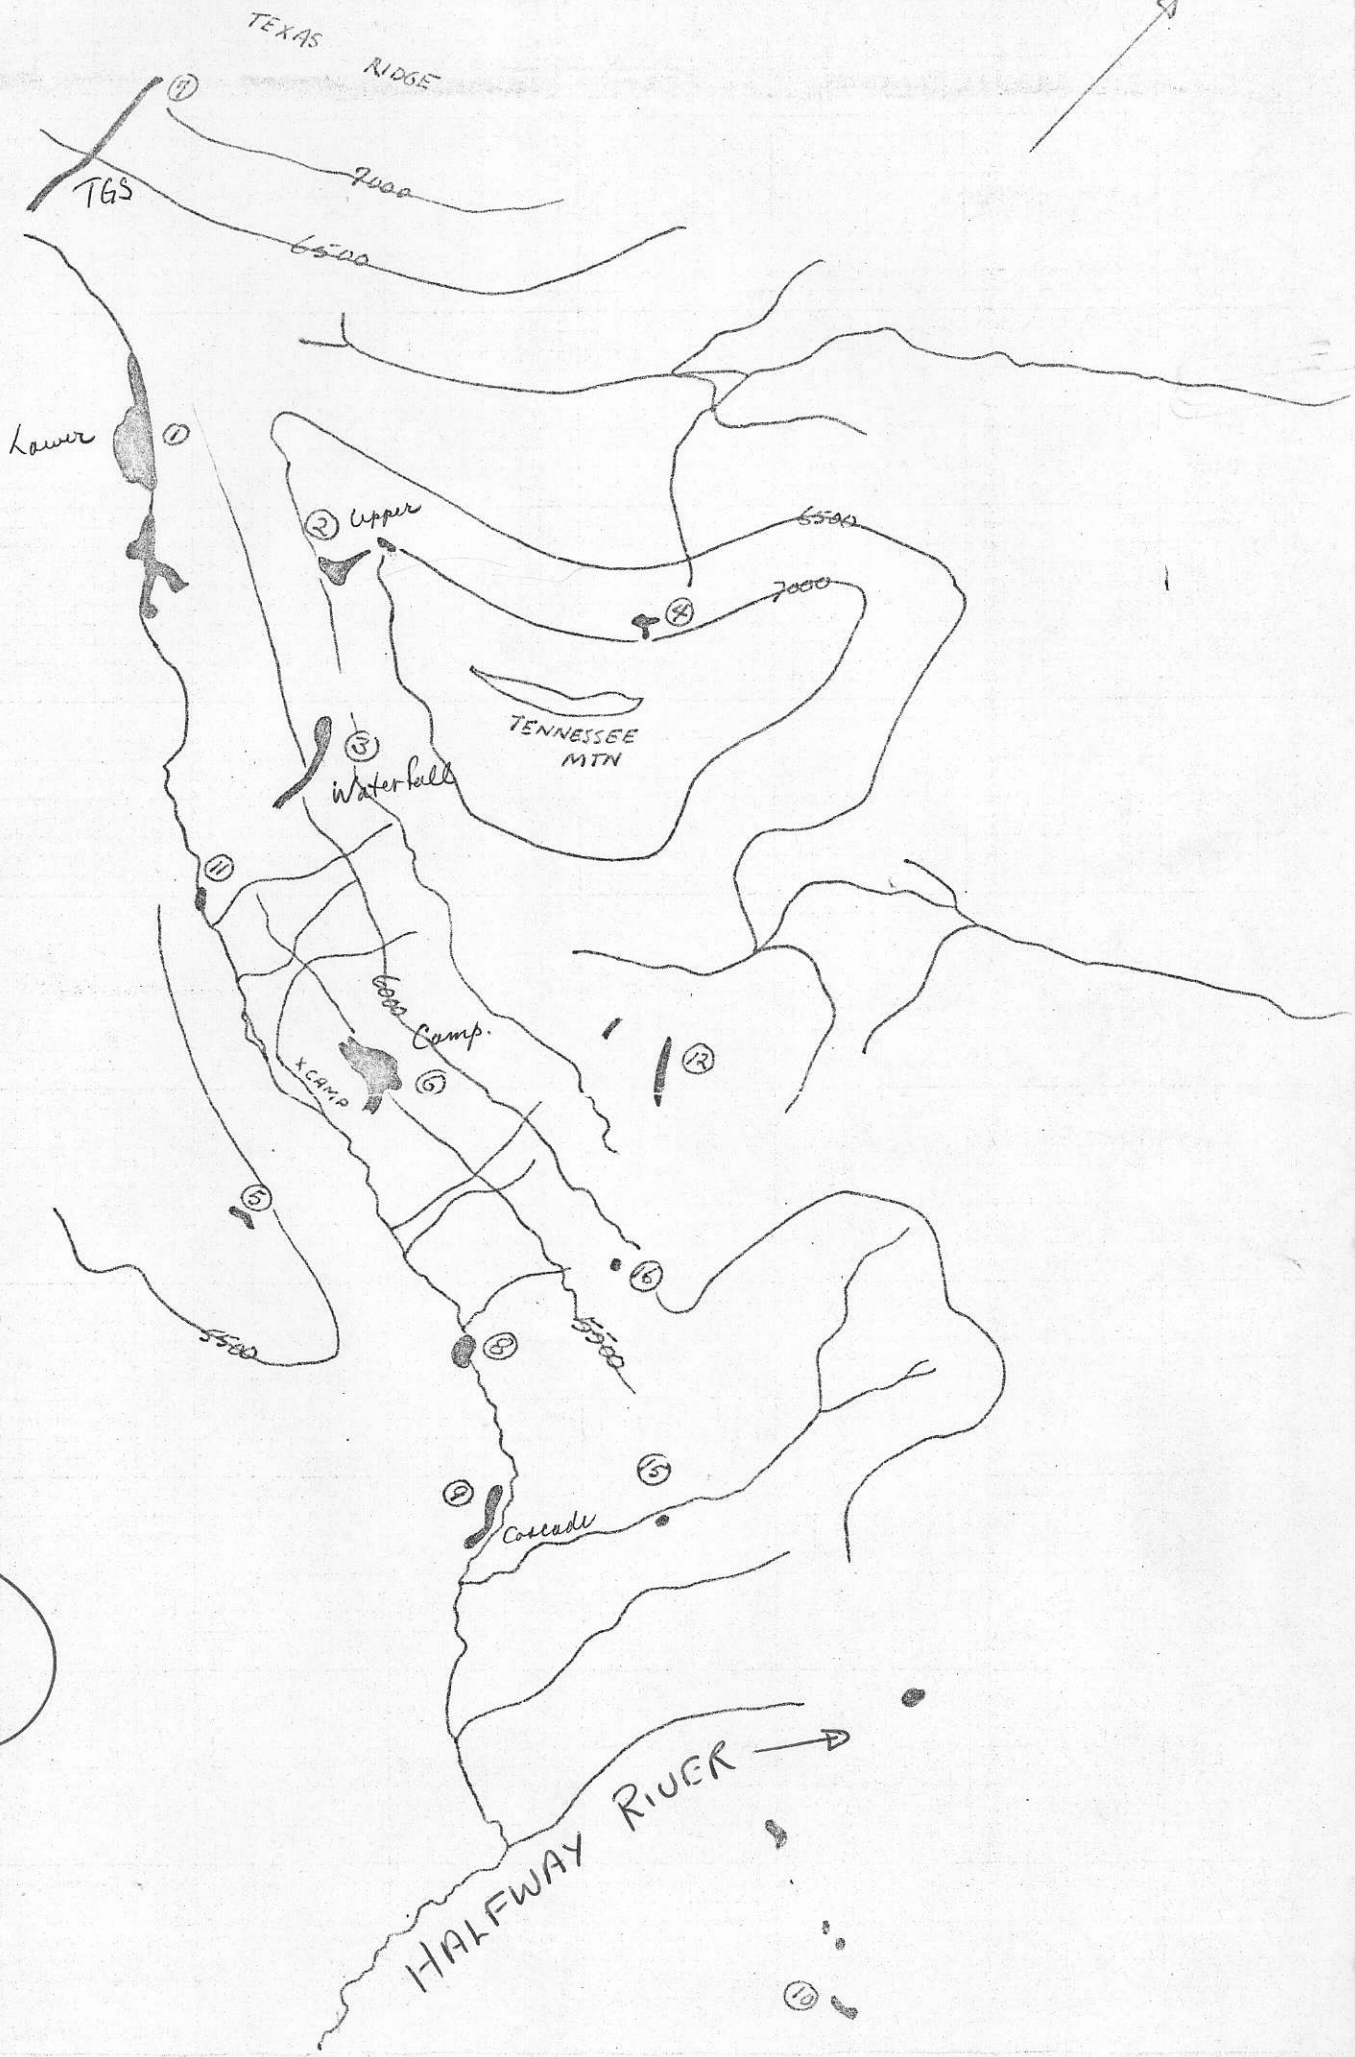

1" = 2000'

ROBB LAKE ←