


41-632 (OLD)

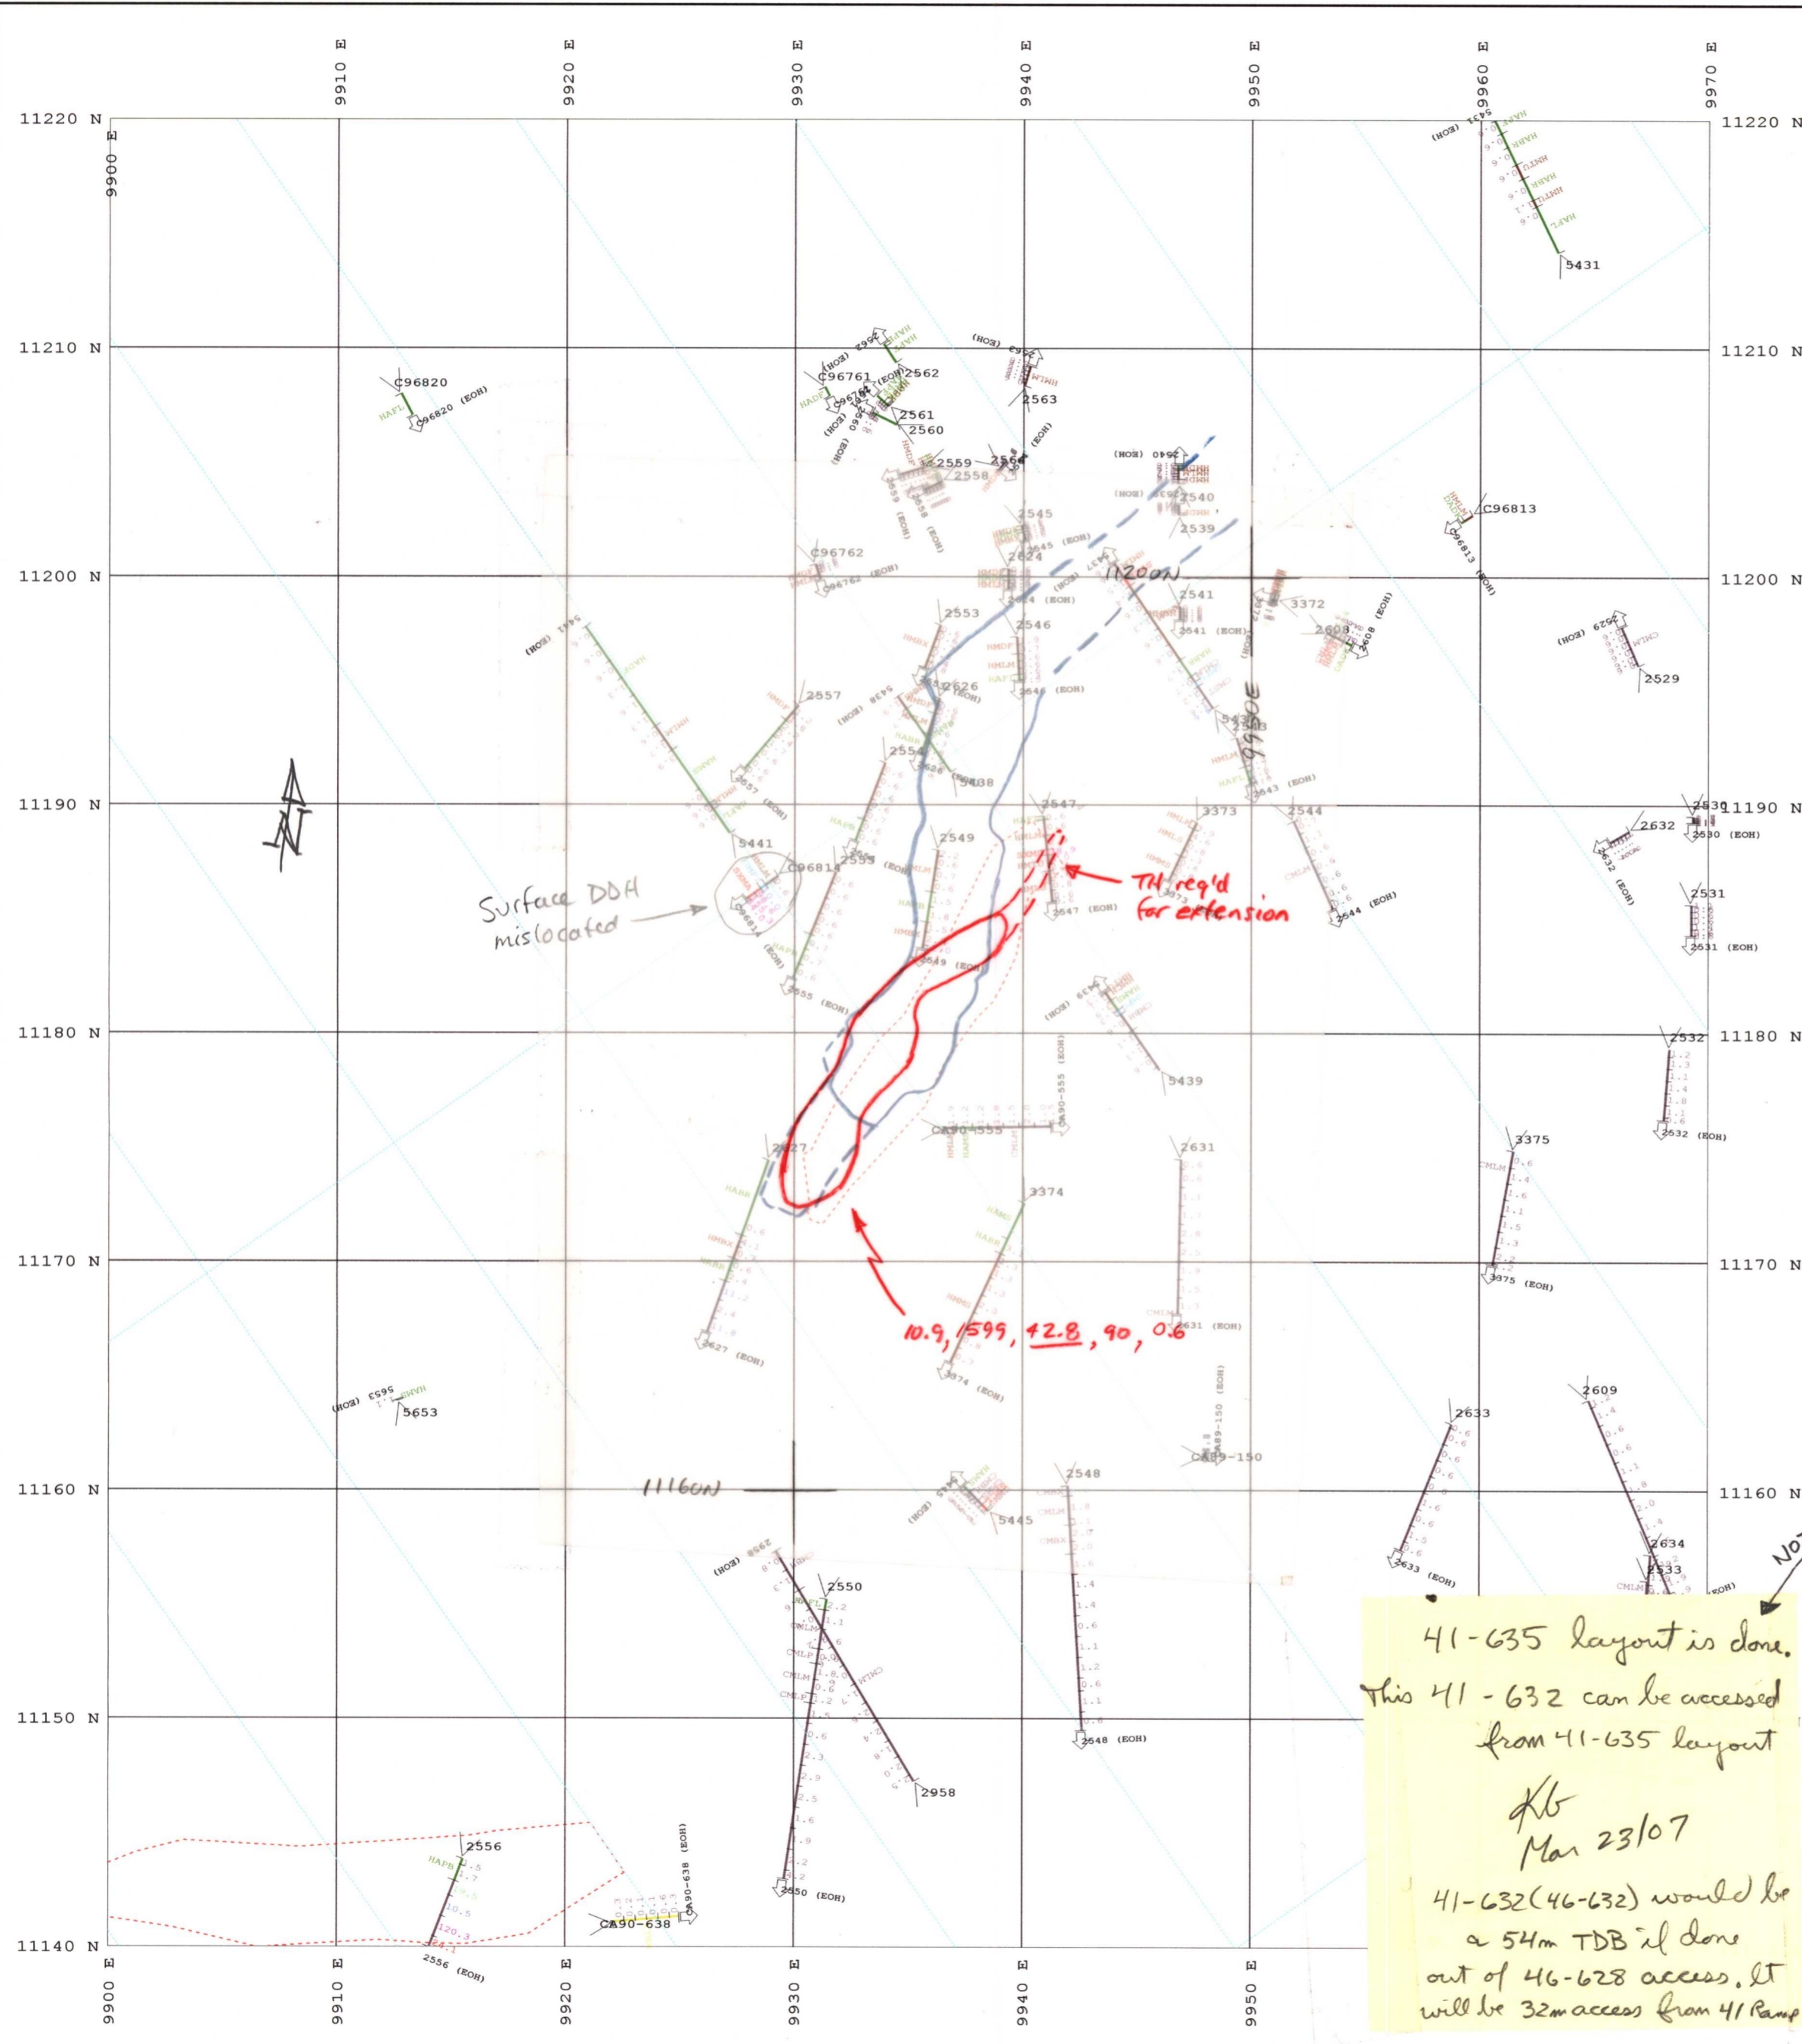

Data fields		LEGEND		
N GEOL (File ESKY.MIN)	Annotation scheme GEOLOGY	BC*	BD*	BM*
CASE	OVER	HA*	HM*	CT
BS*	HA*	FS*	FD*	FA*
FM*	FS*	H2*	SB*	SP*
FU*	HA*	H3*	SB*	DD*
FX*	HA*	H4*	SB*	V*
DI*	HA*	DM*	DM*	FILL
TR	DEFAULT	DM*	DM*	
Non-logged intervals displayed (Value N\L)				
Enter extents symbol				
Exit extents symbol				
Section view cutting plane pierce symbol				
Vertical trace in plan view symbol				
AUEQ (File ESKY.MIN)				
Annotation scheme AUEQ		0.000	5.000	
-1000000.000		8.000	15.000	
		23.000	50.000	
		50.000	100000.000	
		DEFAULT		
Triangulations				
V:/ESKAY/D/RESERVES/TRI/06 21B UNDDL ALL.00T				
V:/ESKAY/D/RESERVES/TRI/06 21C UNDDL ALL.00T				
V:/ESKAY/D/RESERVES/TRI/06 21E UNDDL ALL.00T				
V:/ESKAY/D/RESERVES/TRI/06 HW UNDDL ALL.00T				
V:/ESKAY/D/RESERVES/TRI/06 NEX UNDDL ALL.00T				
V:/ESKAY/D/RESERVES/TRI/06 WT UNDDL ALL.00T				
V:/ESKAY/D/SURVEY/TRI/STOPE/TRI/01STOPE.00T				
V:/ESKAY/D/SURVEY/TRI/STOPE/TRI/02STOPE.00T				
V:/ESKAY/D/SURVEY/TRI/STOPE/TRI/03STOPE.00T				
V:/ESKAY/D/SURVEY/TRI/STOPE/TRI/35STOPE.00T				
V:/ESKAY/D/SURVEY/TRI/STOPE/TRI/41STOPE.00T				
V:/ESKAY/D/SURVEY/TRI/STOPE/TRI/42STOPE.00T				
V:/ESKAY/D/SURVEY/TRI/STOPE/TRI/43STOPE.00T				
V:/ESKAY/D/SURVEY/TRI/STOPE/TRI/44STOPE.00T				
V:/ESKAY/D/SURVEY/TRI/STOPE/TRI/45STOPE.00T				
V:/ESKAY/D/SURVEY/TRI/STOPE/TRI/46STOPE.00T				
V:/ESKAY/D/SURVEY/TRI/STOPE/TRI/48STOPE.00T				
V:/ESKAY/D/SURVEY/TRI/STOPE/TRI/50STOPE.00T				
V:/ESKAY/D/SURVEY/TRI/STOPE/TRI/51STOPE.00T				
V:/ESKAY/D/SURVEY/TRI/STOPE/TRI/60STOPE.00T				
V:/ESKAY/D/SURVEY/TRI/STOPE/TRI/72STOPE.00T				
V:/ESKAY/D/SURVEY/TRI/STOPE/TRI/76STOPE.00T				
V:/ESKAY/D/SURVEY/TRI/STOPE/TRI/62STOPE.00T				
V:/ESKAY/D/SURVEY/TRI/STOPE/TRI/23STOPE.00T				
V:/ESKAY/D/SURVEY/TRI/STOPE/TRI/26STOPE.00T				
Grid lines				
Absolute				

41-635 layout is done.
This 41-632 can be accessed
from 41-635 layout
KB
Mar 23/07
41-632(46-632) would be
a 54m TDB if done
out of 46-628 access. It
will be 32m access from 41 Ramp

NOTE: Good potential for 2 more lifts.
Stepping generally southerly

~~41-632~~
~~41-632~~

RB - 18 Mar 2007

Eskay Creek Mine		Scale: 1:250
41-632		Date: 17-Mar-2007
46-632- HW Stope		Project: ESKY
630.8 mid lift contour		Drawn By: RB
5 metres thick		Checked:
		Approved:
		Drawing No.
		RB_PLAN