

FIELD

TE: [REDACTED] April 25, 1991  
A TO: A. J. Davidson  
COPIES A TO: D. H. Watkins, I. D. Pirie  
COPIES TO:  
DE FROM: C. Burge  
SUBJECT: 1991 Diamond Drill Proposal - Seneca Option

---

The following proposal is designed to supplement the 1990 diamond drill proposal (November 13, 1990).

A **4000 meter** drill program is proposed to follow up high grade massive sulphide intercepts and explore new horizons at the Seneca property. The program will take place in two stages; a spring 3000 meter program and a fall program consisting of 1000 meters.

### Seneca Pit Area Targets

The Seneca pit area is the site of the Seneca deposit. The deposit consists of several massive sulphide intersections at the same stratigraphic interval over an area measuring 450m by 250 m. Unfortunately infill drilling was unable to establish continuity between these zones. The apparent random distribution of massive sulphides, lack of metal zonation and lack of a footwall stockwork/alteration pipe suggest that massive sulphides have been mechanically transported to their current position.

The potential in the Seneca pit area will be evaluated with four holes that will test the downdip potential. P1 (and P11) will follow up massive sulphides intersected in 85-3 situated 35 meters above the Seneca horizon. This intercept is underlain by a 20 meter gypsum bearing sphalerite-pyrite stockwork and may represent an important new horizon. P9 and P10 are 700m and 400m stepouts north and east of the deposit and will be drilled in the fall due to access difficulties (snow).

A total of four short holes and one extension (85-7) will test zinc bearing turbidite situated 100 meters stratigraphically below the Seneca horizon. The holes will test trace element soil anomalies emanating from this highly prospective sediment package. The target horizon is underlain by a dacitic ash flow tuff, an important contact in the nearby Britannia camp (P2,3,4,5,13).

## Vent Area Targets

The Vent showing is located 1.8 km. west of the Seneca occurrence and was discovered during a logging operation in 1985. The Vent discovery is a spectacular sphalerite rich stockwork developed in a felsic dome and outcrop channel samples yielded zinc values averaging 9% over 9 meters. The mineralization is accompanied by a soda depletion zone measuring 200m by 400m and cuts across several units in a northerly direction. P15 will test stratigraphy above the most intense and stratigraphically highest alteration in the Vent area.

Six holes are proposed to follow up a 1987 intercept grading .43% Cu, 1.2% Pb, 5.68% Zn, 80 gpt Ag and .8 gpt Au/3.03 meters (P6-8, P12, P14, P15). The immediate hanging wall unit contains over 5% barium and the sulphides are underlain by a 25 meter soda depleted zinc rich stockwork. This intersection is open in all directions and occurs about 800 meters west of the spectacular Vent stockwork showing.

P16, located 200m east of the Vent zone, will test the lower contact of the Vent dome where a 3 meter zone graded 3.92% Zn. P17 will test the Vent rhyolite lower contact where it coincides with a Mag and VLF conductor.

## Geophysics

A VLF-EM and Mag survey has just been completed over the Vent area and has provided conductors that support our geologic interpretation. Two main conductive zones occur above and below the Vent rhyolite. The strongest conductor occurs in the area grid northwest of the Vent stockwork system and west of S-90-01. The conductive zone measures 500 meters (L93E to L98E at 3+75N) and will be tested by P7.

All drillholes will be probed using Pulse EM methods and if mineralized zones provide a response a large in-loop survey of the Vent area will be undertaken.

## Conclusions

The 1991 drill program will test top priority targets generated during the 1990 field season. A complete evaluation of all previous work combined with an integrated exploration approach has led to development of good solid targets and further refinement of the geologic model for the property. The Vent area has not been tested using VMS exploration concepts despite being within 2 km of transported Kuroko type ore of the Seneca deposit. The 1991 program will complete mandatory follow-up work as a result of previous operators and begin evaluating new horizons showing excellent promise.

**Table 1. Proposed Diamond Drilling Holes – Seneca Property**

| Hole #           | Line   | Stn.   | Azim.<br>(deg)               | Dip<br>(deg)                 | Length                | Cost     | Target  |
|------------------|--------|--------|------------------------------|------------------------------|-----------------------|----------|---|
| <i>S91-02</i> P1 | 2+40E  | 2+50N  | 050                          | -60                          | <i>200.2</i><br>300 m | \$19,500 | A 200 meter step-out on 85-3 MS intercept (10.1% Zn, .17 opt Au/0.64 m) situated above a 20 meter pyrite/gypsum stockwork sulphide system <i>S91-02</i>                 |
| <i>85-7</i> P2   | 1+50E  | 3+00S  | 230                          | -80                          | <i>170.1</i><br>100 m | \$6,500  | Will test zinc bearing sediments stratigraphically below the Seneca deposit. This hole is an extension of 85-7 which was terminated in Qtz-Py-Zn mineralization         |
| <i>S91-03</i> P3 | 4+35E  | 10+20S | 050                          | -80                          | <i>159.7</i><br>100 m | \$6,500  | P3 will test the SE strike extension of zinc bearing turbidites and a coincident barium soil anomaly.   |
| <i>S91-04</i> P4 | 5+00W  | 4+50S  | 230                          | -80                          | <i>149.7</i><br>150 m | \$9,750  | Will test a Cu-Pb-Ba soil anomaly within the zinc exhalite sediment package 400 m east of previous drilling. <i>rods stuck</i>  |
| P5               | 3+10W  | 1+20S  | 230                          | -80                          | 150 m                 | \$9,750  | Will test zinc bearing sediments situated stratigraphically below Seneca and in the vicinity of a postulated synvolcanic fault.   |
| <i>S91-09</i> P6 | 92+15E | 4+00N  | <del>050</del>               | <del>-70</del><br><i>-90</i> | <i>206.5</i><br>250 m | \$16,250 | P6 will follow up MS intercept in 87-12, 250 m North  |
| <i>S91-05</i> P7 | 96+00E | 5+70N  | <del>050</del><br><i>230</i> | -80                          | <i>275.8</i><br>350 m | \$22,750 | P7 will test an IP anomaly west of S-90-01  |
| <i>S91-07</i> P8 | 94+65E | 2+20N  | 050                          | <del>-80</del><br><i>-75</i> | <i>211.8</i><br>200 m | \$13,000 | P8 will test the east strike extension (towards the Vent) of massive sulphides intersected in 87-12.  |
| P9               | 8+00W  | 9+00N  | 230                          | -70                          | 750 m                 | \$48,750 | P9 will test the Seneca deposit sequence 500 m west of the pit and 500 m down dip. This hole will also test the down dip potential of barite enriched Trough sediments. |






**Table 1. Proposed Diamond Drilling Holes – Seneca Property (cont.)**


| Hole #      | Line    | Stn.   | Azim.                        | Dip                   | Length                           | Cost     | Target   |
|-------------|---------|--------|------------------------------|-----------------------|----------------------------------|----------|--|
|             |         |        | (deg)                        | (deg)                 |                                  |          |  |
| P10         | 8+50W   | 1+50S  | 230                          | -75                   | 600 m                            | \$32,500 | P10 will test the Seneca deposit sequence 750 m E and will also test barite enriched Trough seds, 300 meters downdip.            |
| P11         | 00+00   | 4+00N  | 230                          | -80                   | 50 m                             | \$3,250  | P11 will test postulated occurrence of the Seneca deposit sequence stratigraphically above previous drilling 300 m W of the pit. |
| S-91-10 P12 | 90+00E  | 3+10N  | <del>230</del><br>230        | <del>-75</del><br>-80 | <del>200</del><br>246.3<br>200 m | \$13,000 | P12 is contingent on results of P6 and P8 and will test massive sulphides in 87-12, 250 m to the west.                           |
| P13         | 7+10E   | 11+00S | 230                          | -85                   | 100 m                            | \$6,500  | P13 will test a Cu, Pb and Zn anomaly in Trough sediments more than 500 meters SE of all previous drilling.                      |
| S91-08 P14  | 91+85E  | 1+30N  | 230                          | <del>-80</del><br>-70 | <del>200</del><br>221.9<br>200 m | \$13,000 | P14 will test the continuity of massive sulphides intercepted in 87-12, 200 m S.   |
| S91-06 P15  | 97+00E  | 1+80N  | <del>230</del><br>050<br>280 | -80                   | <del>200</del><br>226.8<br>200 m | \$13,000 | P15 will test the Vent alteration pipe 300 m west and continue testing the 87-12 MS horizon 525 m E.                             |
| P16         | 101+87E | 0+15S  | 230                          | -80                   | 200 m                            | \$13,000 | P16 tests Vent dome/And-white fragment breccia contact   |
| P17         | 95+35E  | 0+35S  | 230                          | -80                   | 100 m                            | \$6,500  | P17 will test the lower Vent horizon and a coincident Mag/VLF anomaly  |

**Total 4000 m 260,000**

Costs include direct drilling costs, assays, salaries @ \$65/m

LEGEND

- 1 Mafic Volcanics
- 2 Intermediate Volcanics
- 6 Felsic Intrusives
- 3 Felsic Volcanics
- 5 Mafic Intrusives
- 4 Sediments
-  Trough Zinc Exhalite
-  Seneca Transported Ore
-  Seneca Horizon
-  Vent Stockwork/Alteration Pipe
-  Proposed DDH Location

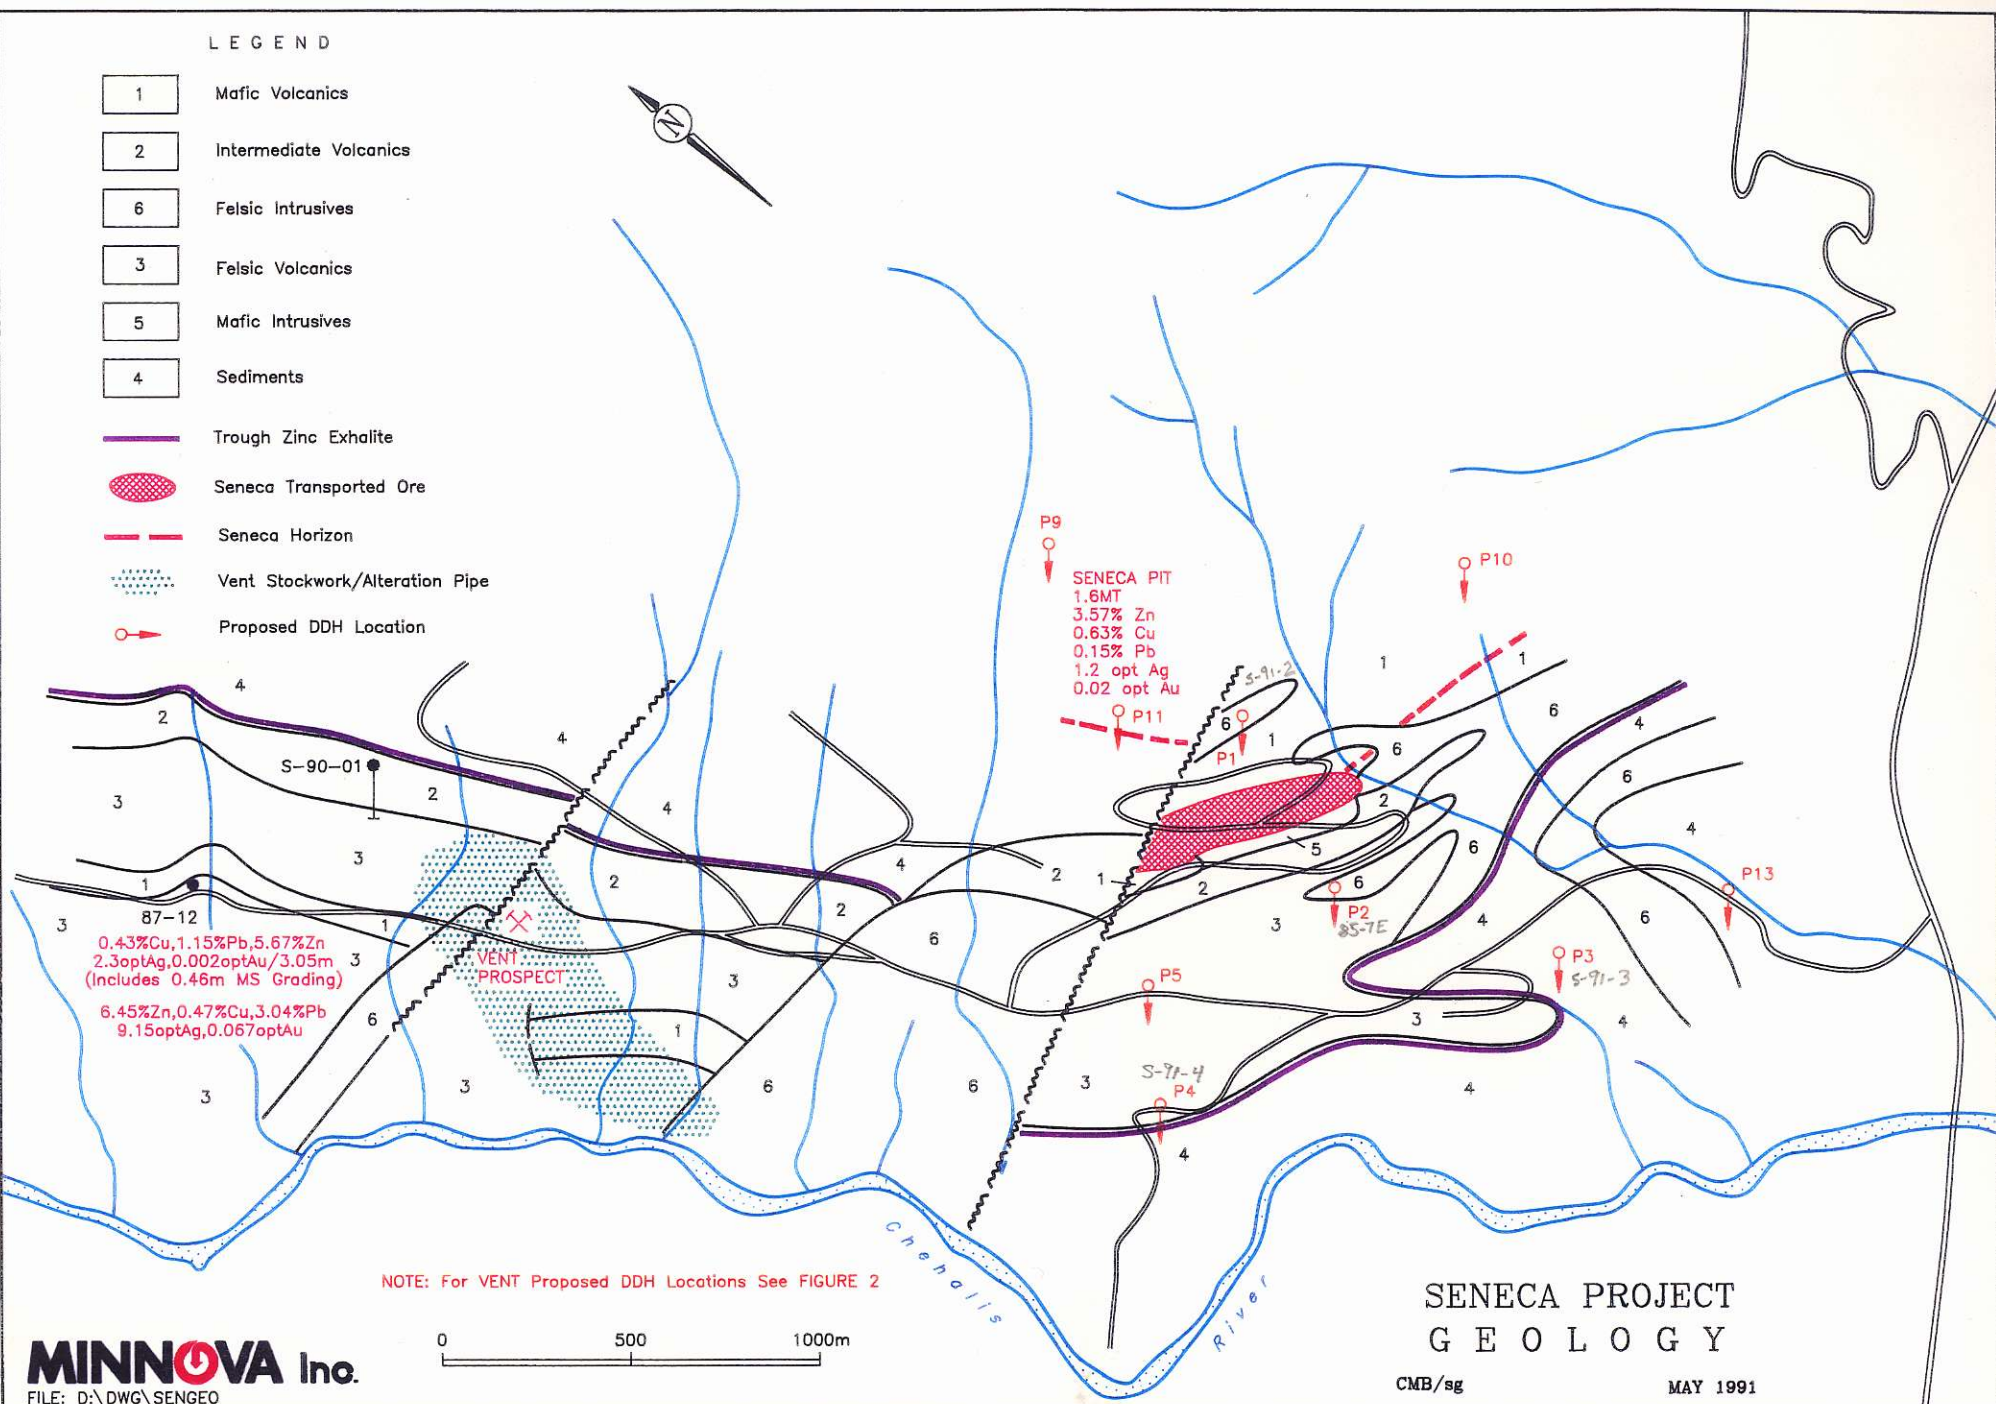


P9  
 SENECA PIT  
 1.6MT  
 3.57% Zn  
 0.63% Cu  
 0.15% Pb  
 1.2 opt Ag  
 0.02 opt Au

87-12  
 0.43%Cu, 1.15%Pb, 5.67%Zn  
 2.3optAg, 0.002optAu/3.05m  
 (Includes 0.46m MS Grading)

6.45%Zn, 0.47%Cu, 3.04%Pb  
 9.15optAg, 0.067optAu


NOTE: For VENT Proposed DDH Locations See FIGURE 2

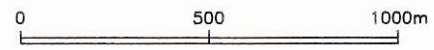

SENECA PROJECT  
 GEOLOGY

CMB/sg

MAY 1991

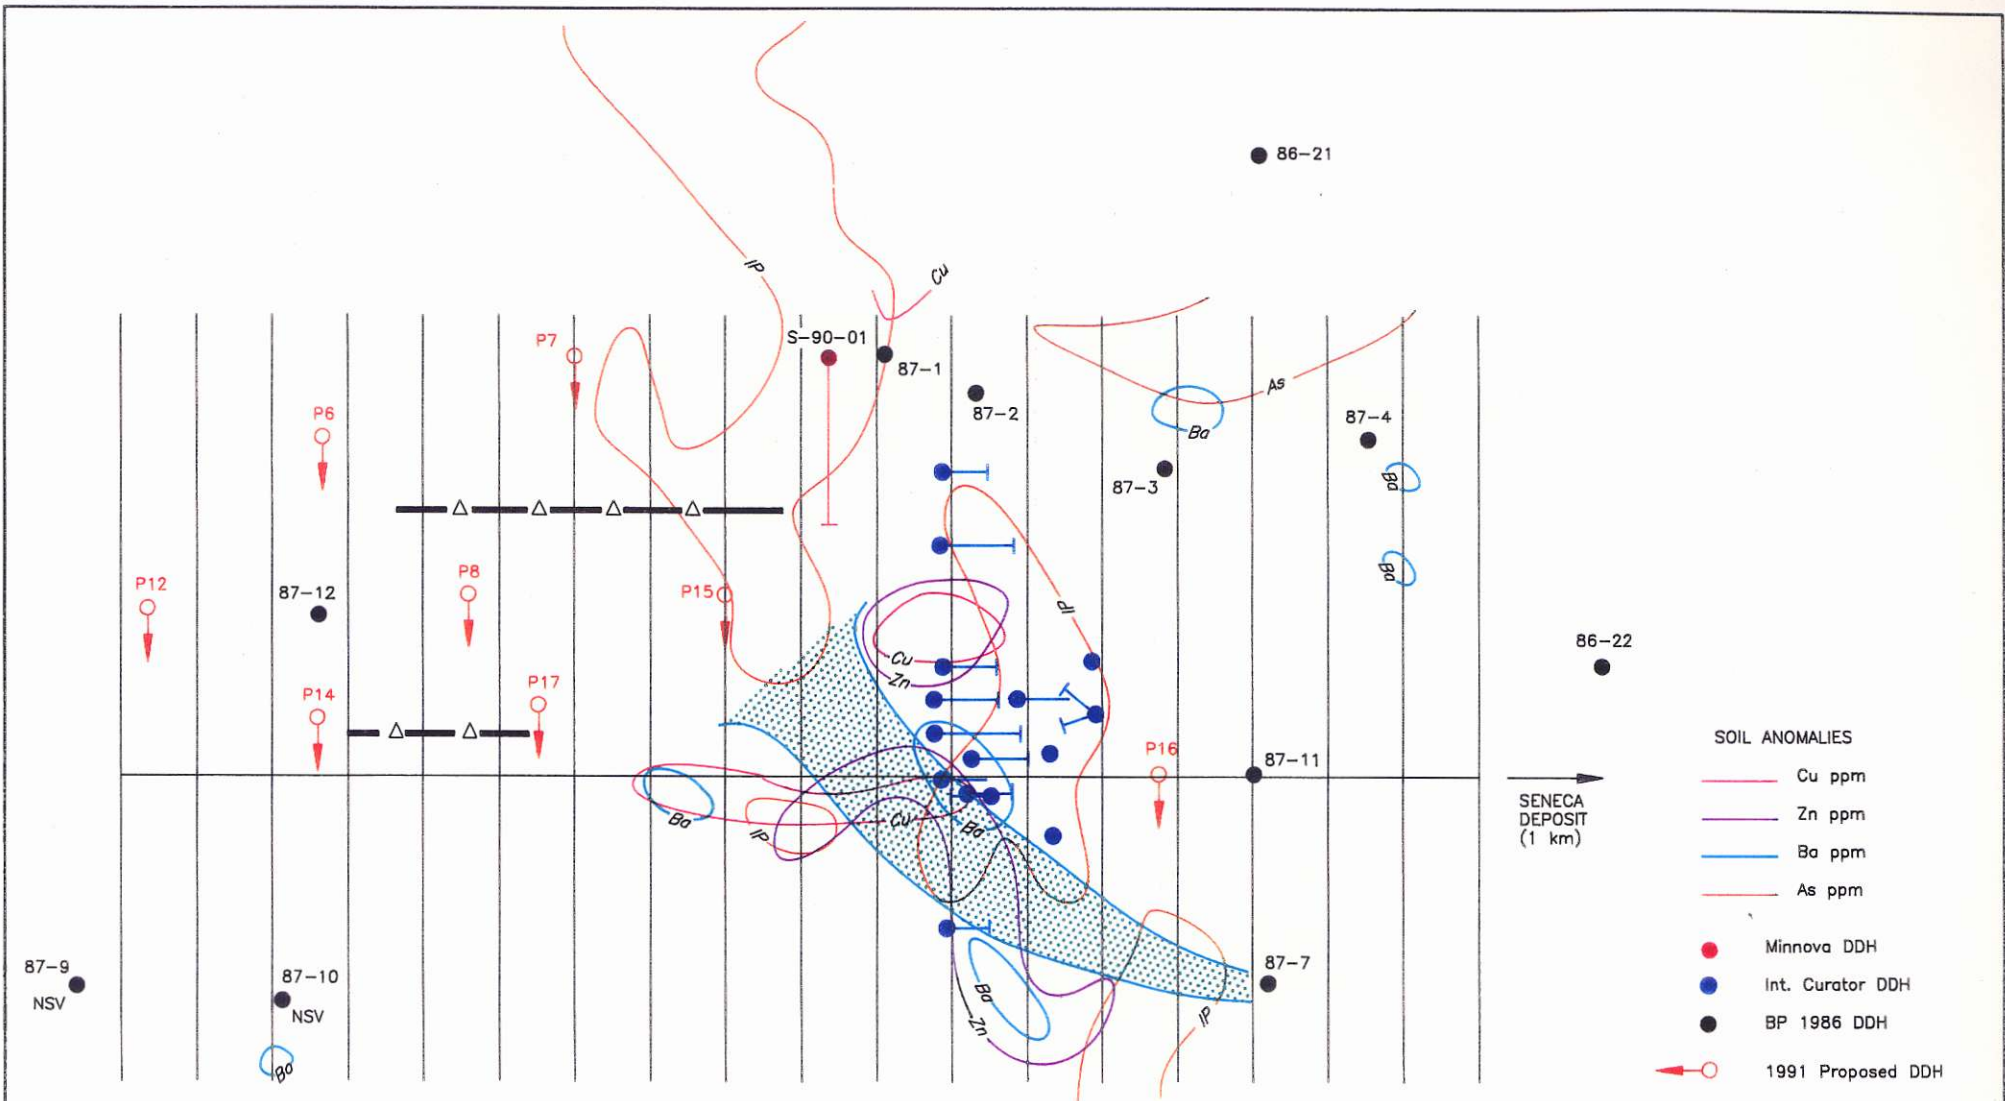

87-12 : 0.43%Cu,1.15%Pb,5.67%Zn,79.8g/tAg,0.79g/tAu/3.05m @ 125m depth

- IP Anomaly
- Na<sub>2</sub>O Depletion Zone
- △ VLF Conductor Axis

- SENECA DEPOSIT (1 km) →
- SOIL ANOMALIES**
- Cu ppm
  - Zn ppm
  - Ba ppm
  - As ppm
- Minnova DDH
  - Int. Curator DDH
  - BP 1986 DDH
  - 1991 Proposed DDH


0 100 200 300m  
SCALE: 1 : 10000

# SENECA PROJECT VENT GRID


SW


NE

- Ⓐ .88% Cu, 3.56% Zn, .17% Pb, 64g/t Ag, 1.07g/t Au/10.30m
- Ⓑ .70% Cu, 5.20% Zn, .09% Pb, 48g/t Ag, 1.47g/t Au/4.14m
- Ⓒ .36% Cu, 10.10% Zn, .72% Pb, 247g/t Ag, 5.97g/t Au/0.64m

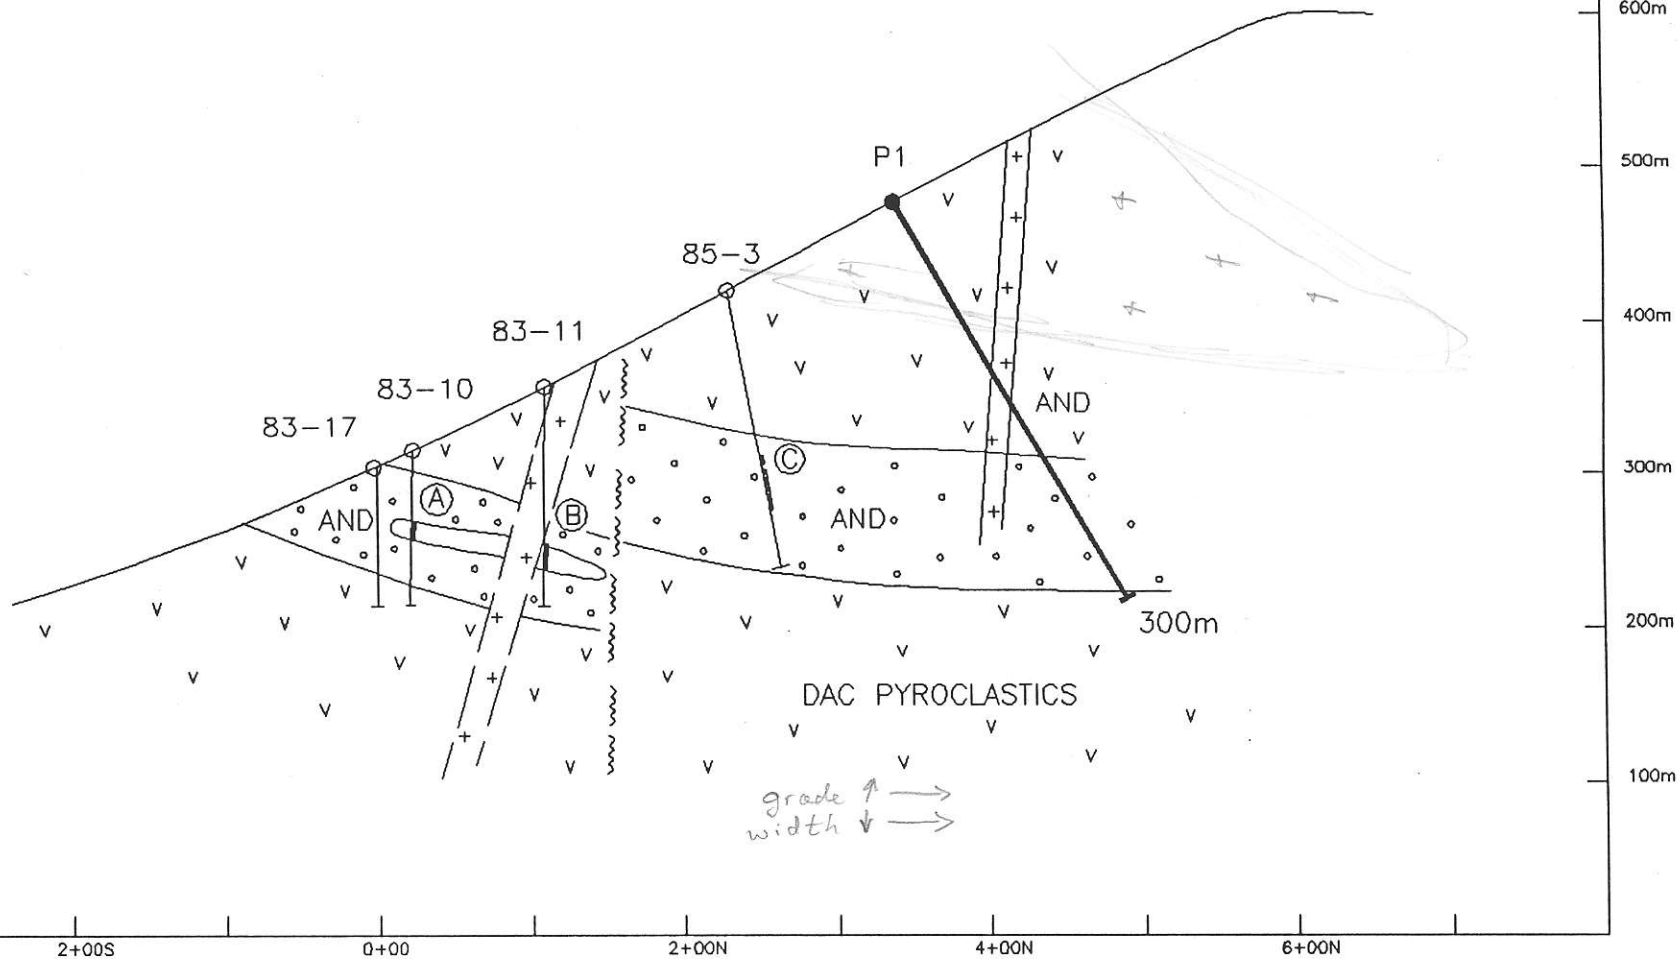


SECTION 0+00 (P1)

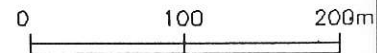


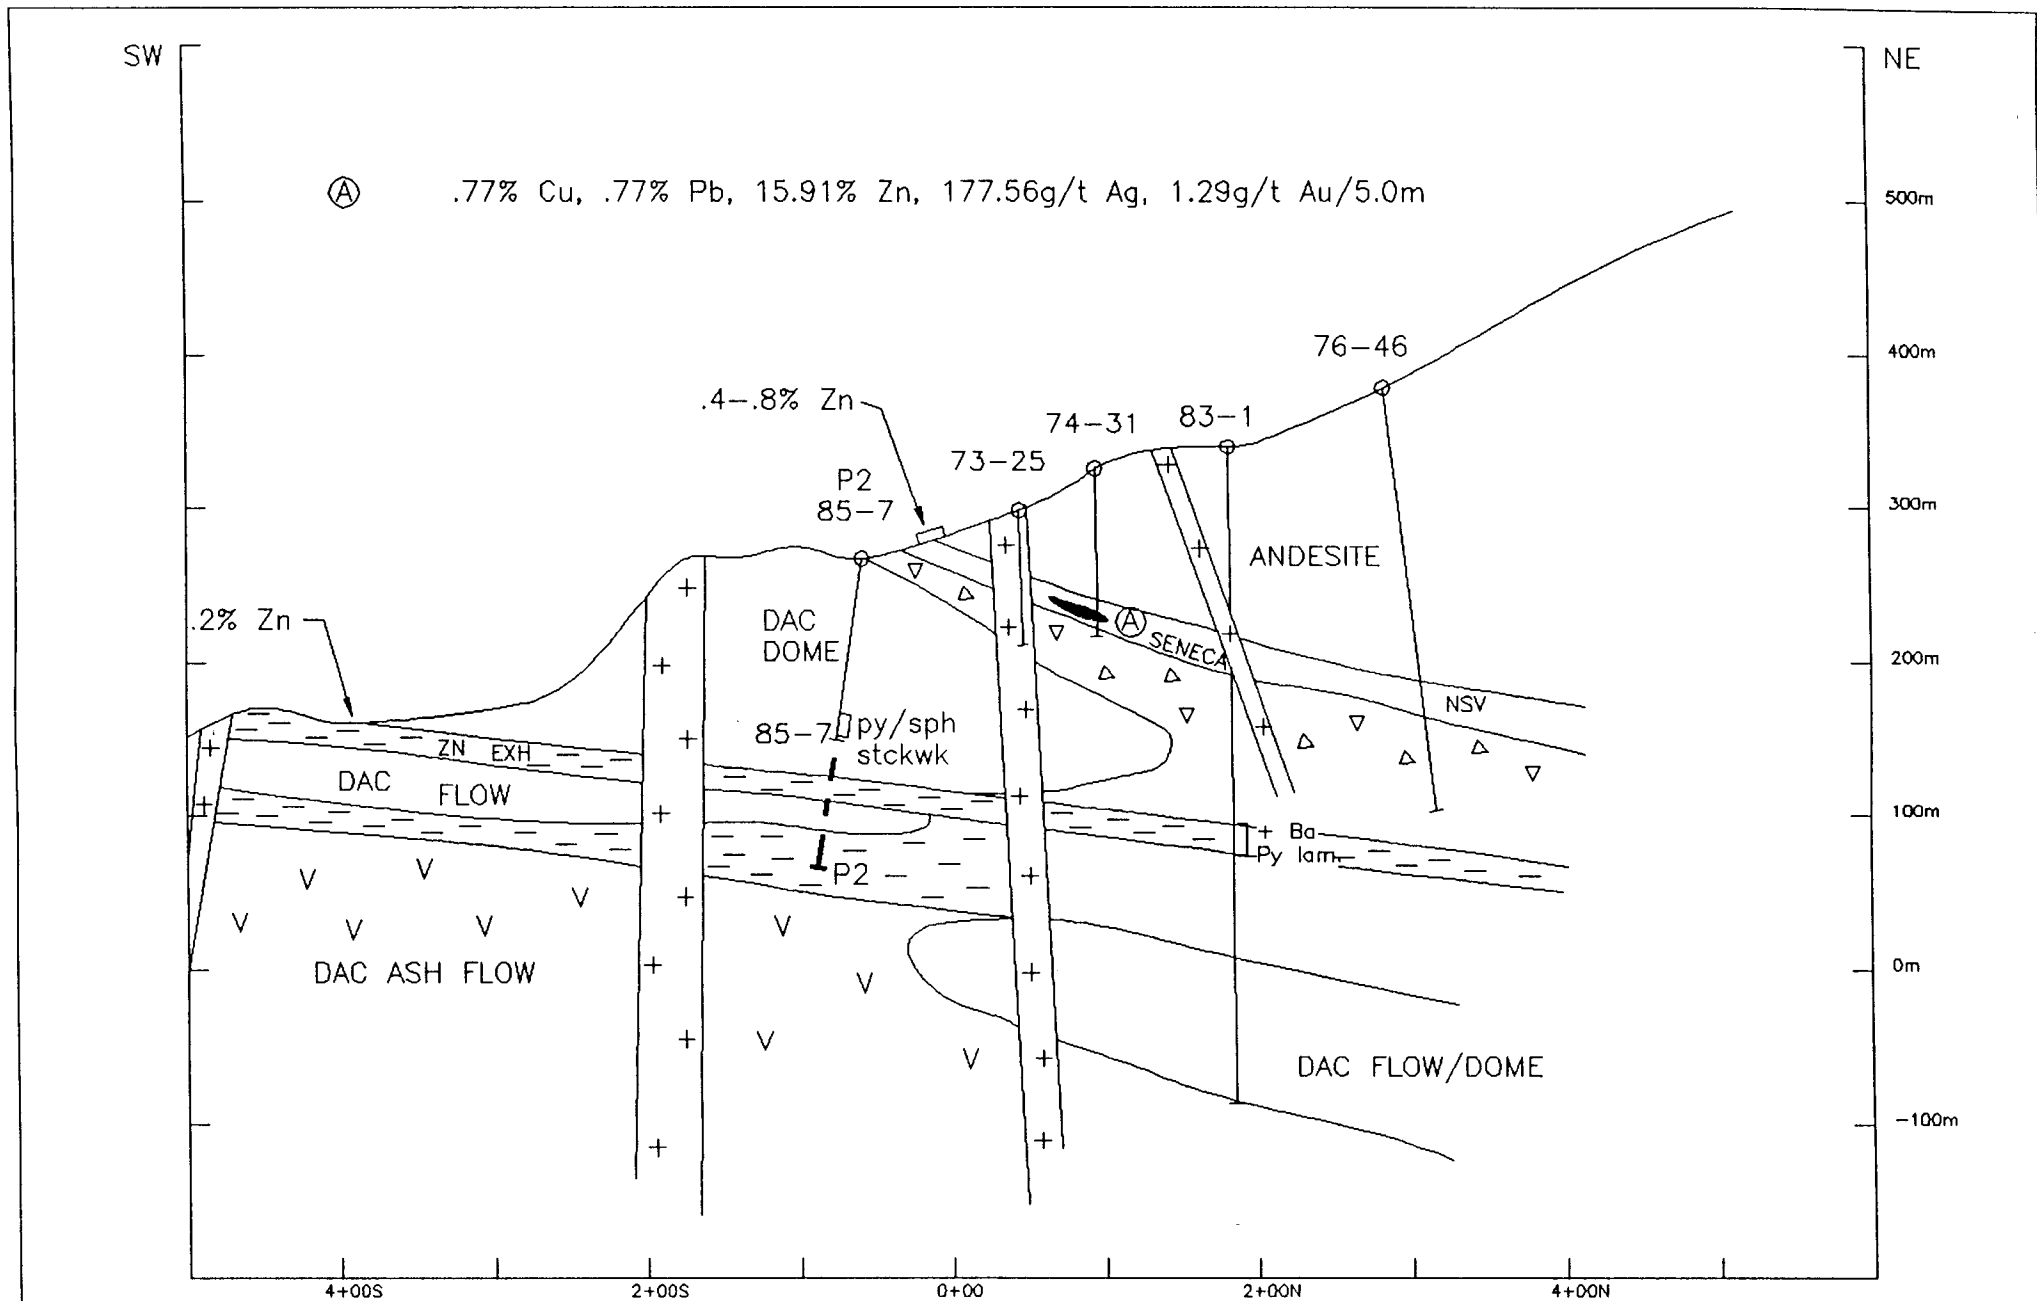


SECTION 3+50 EAST (P2 - EXTENSION OF 85-7)

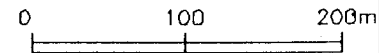




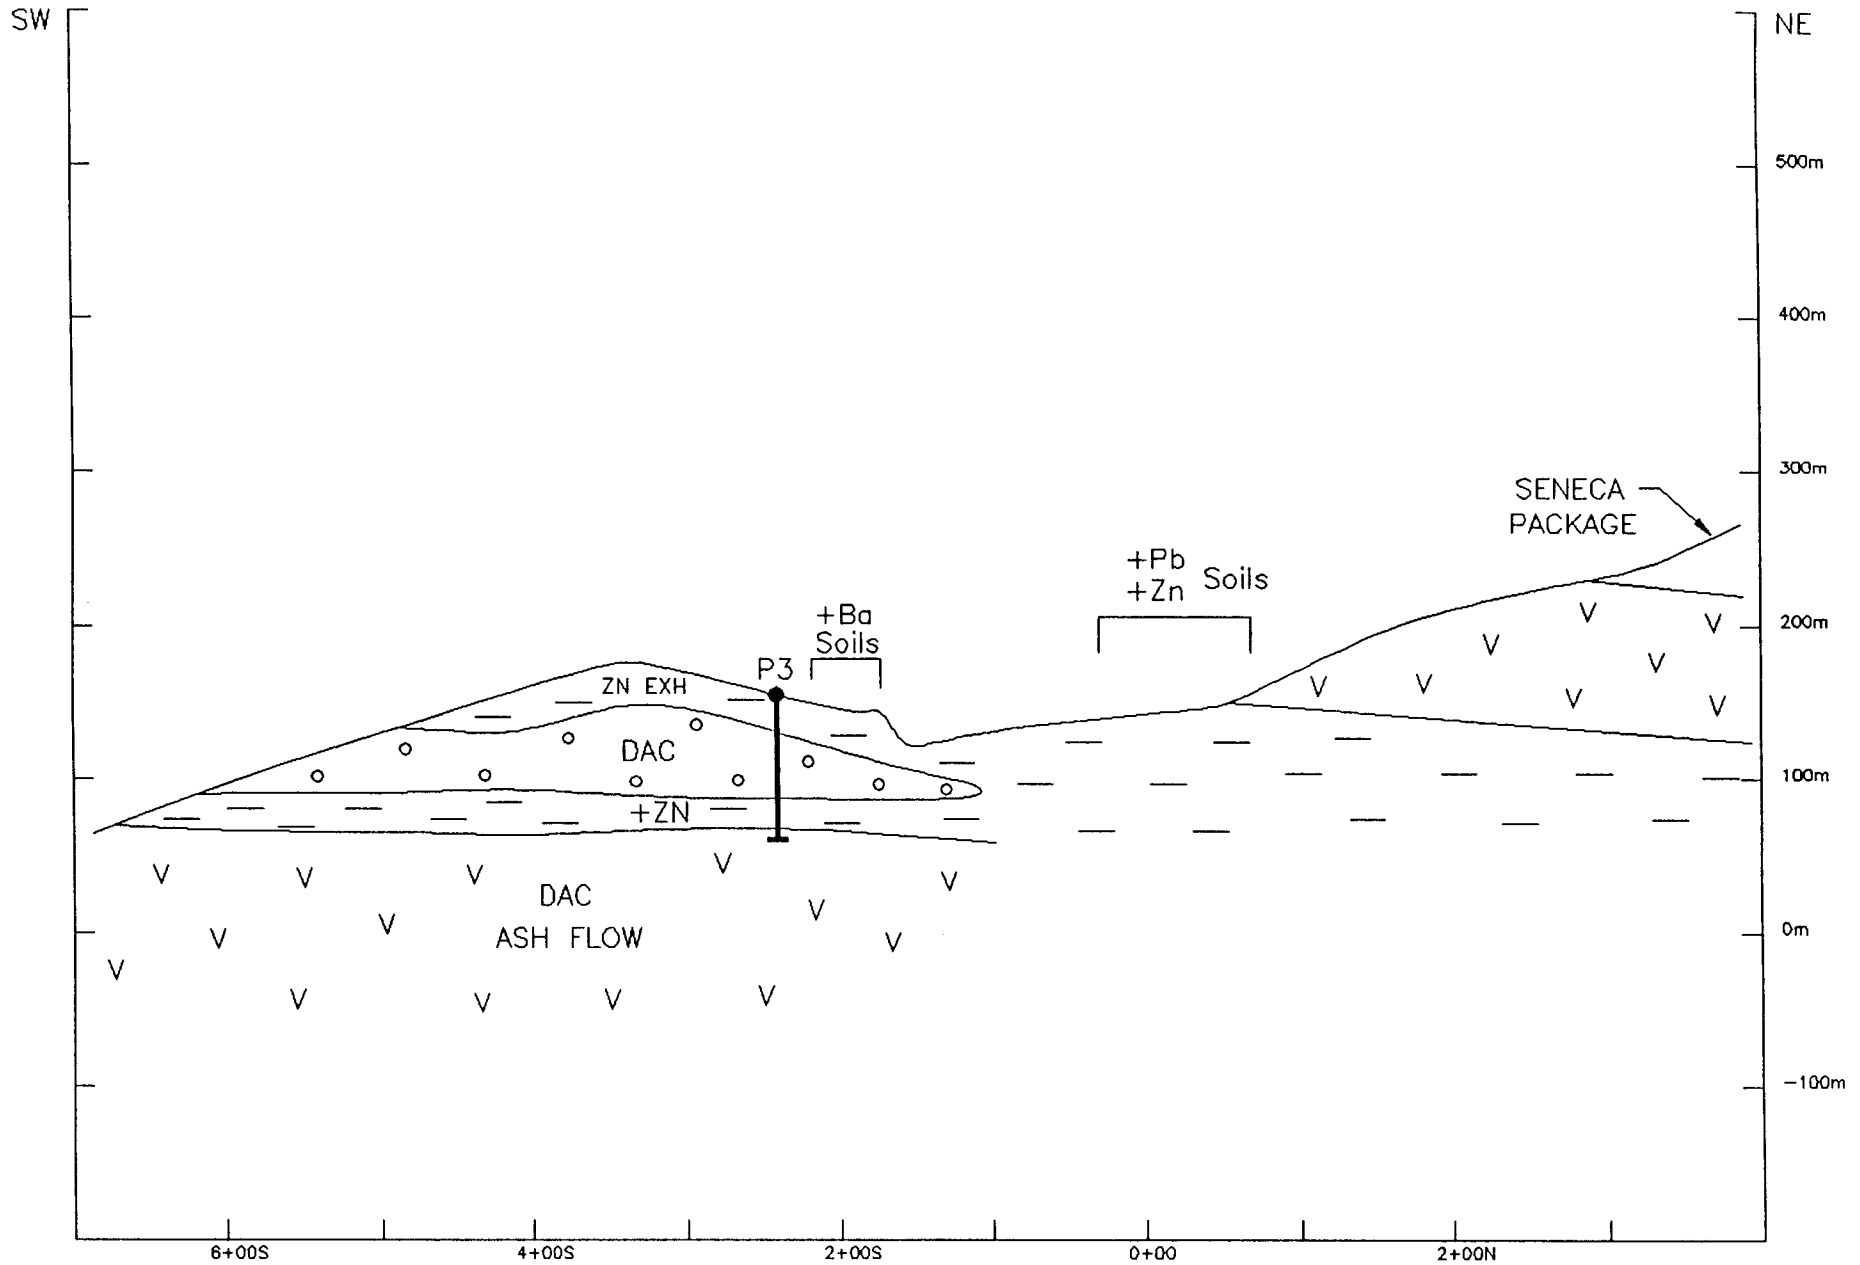



SECTION 11+50E (P3)

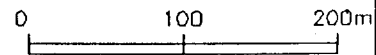

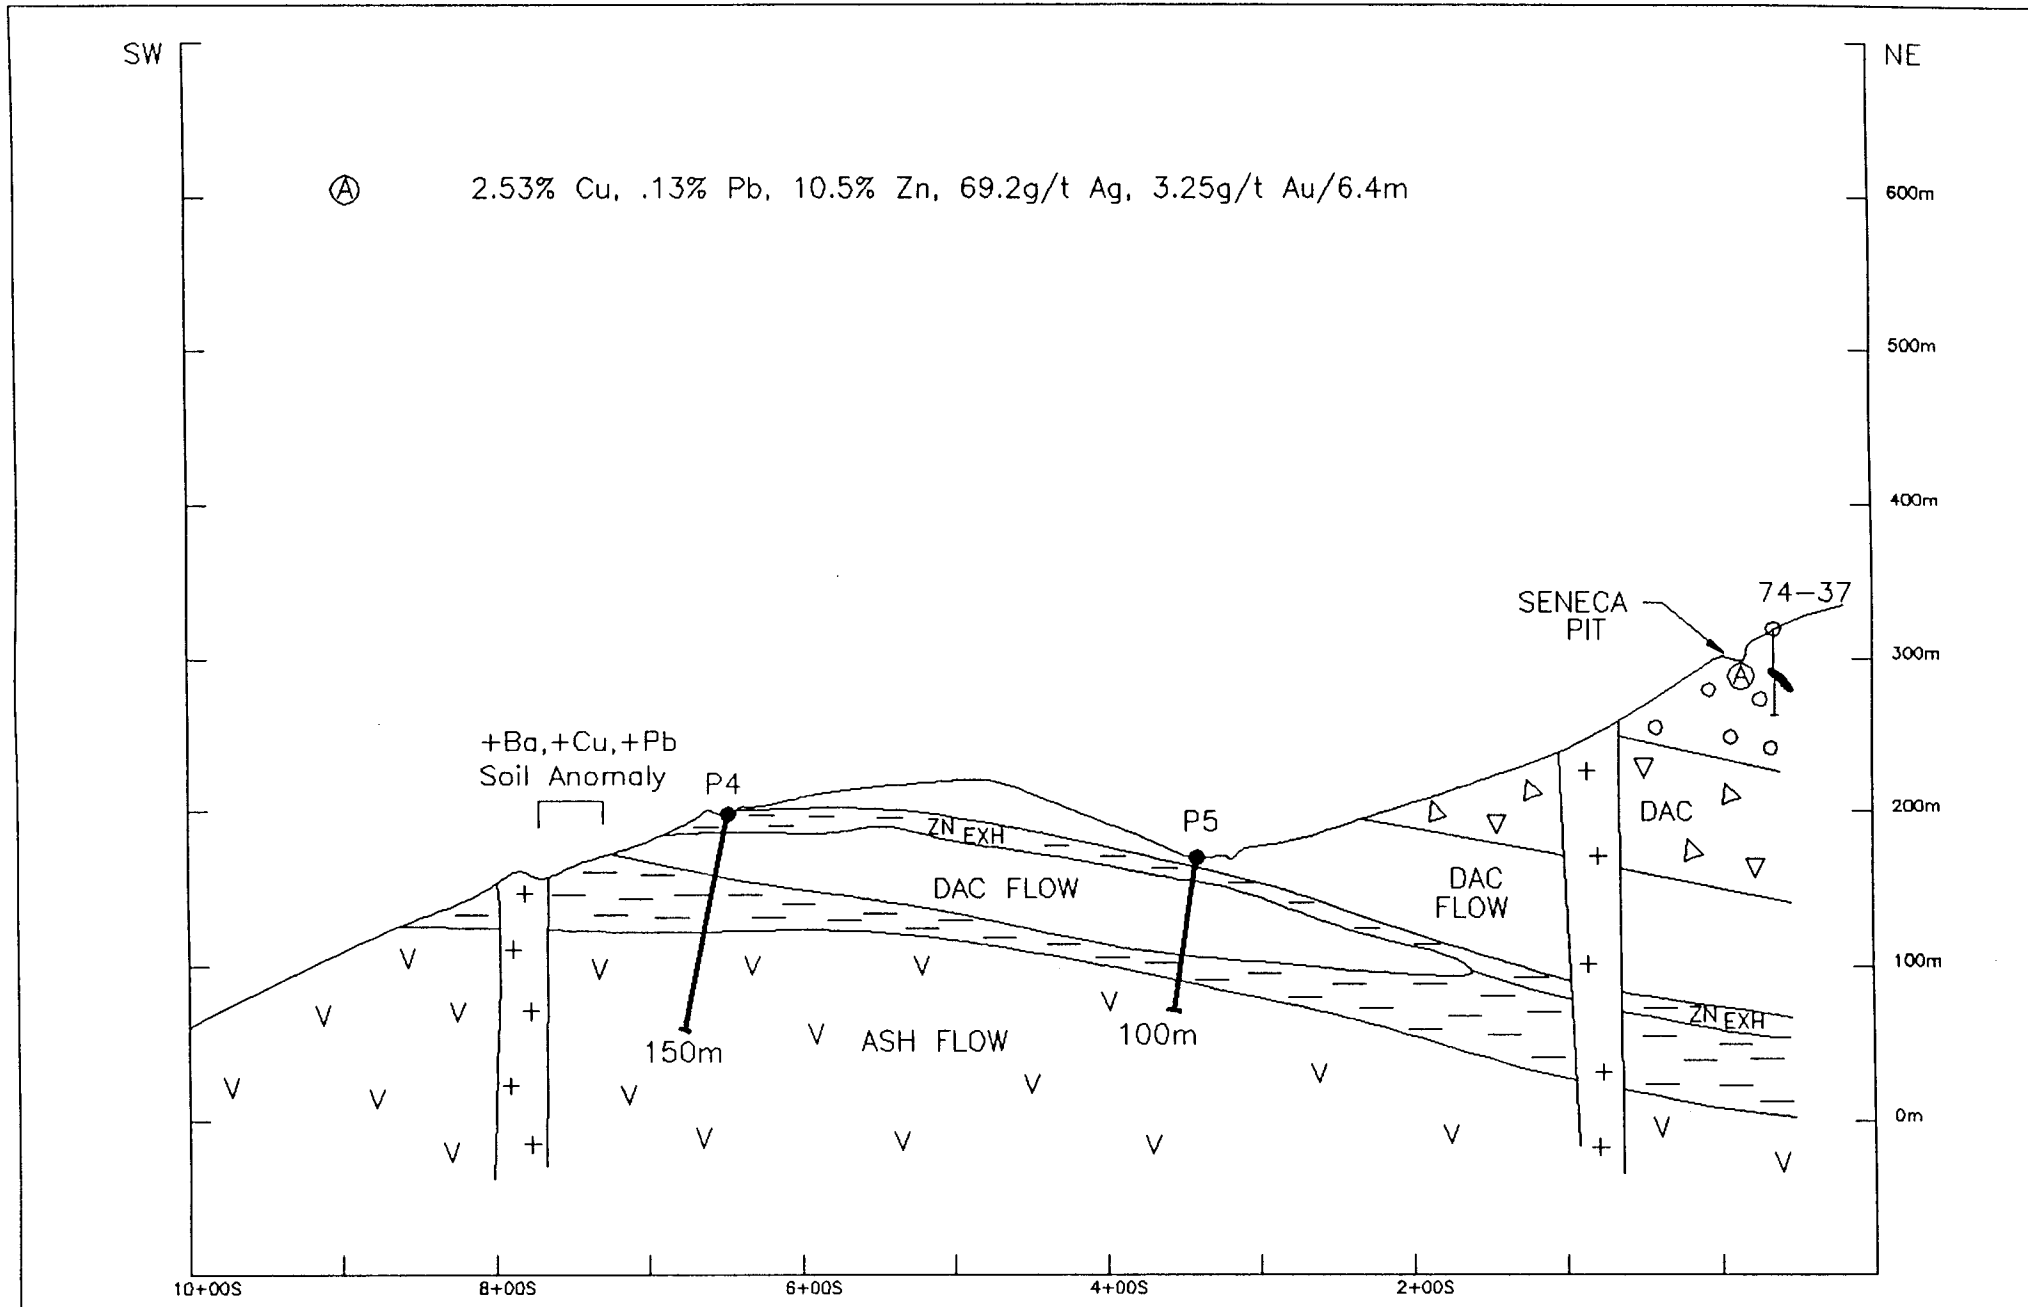



SECTION 0+50W LOOKING NORTHWEST (P4, P5)

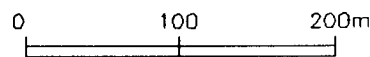

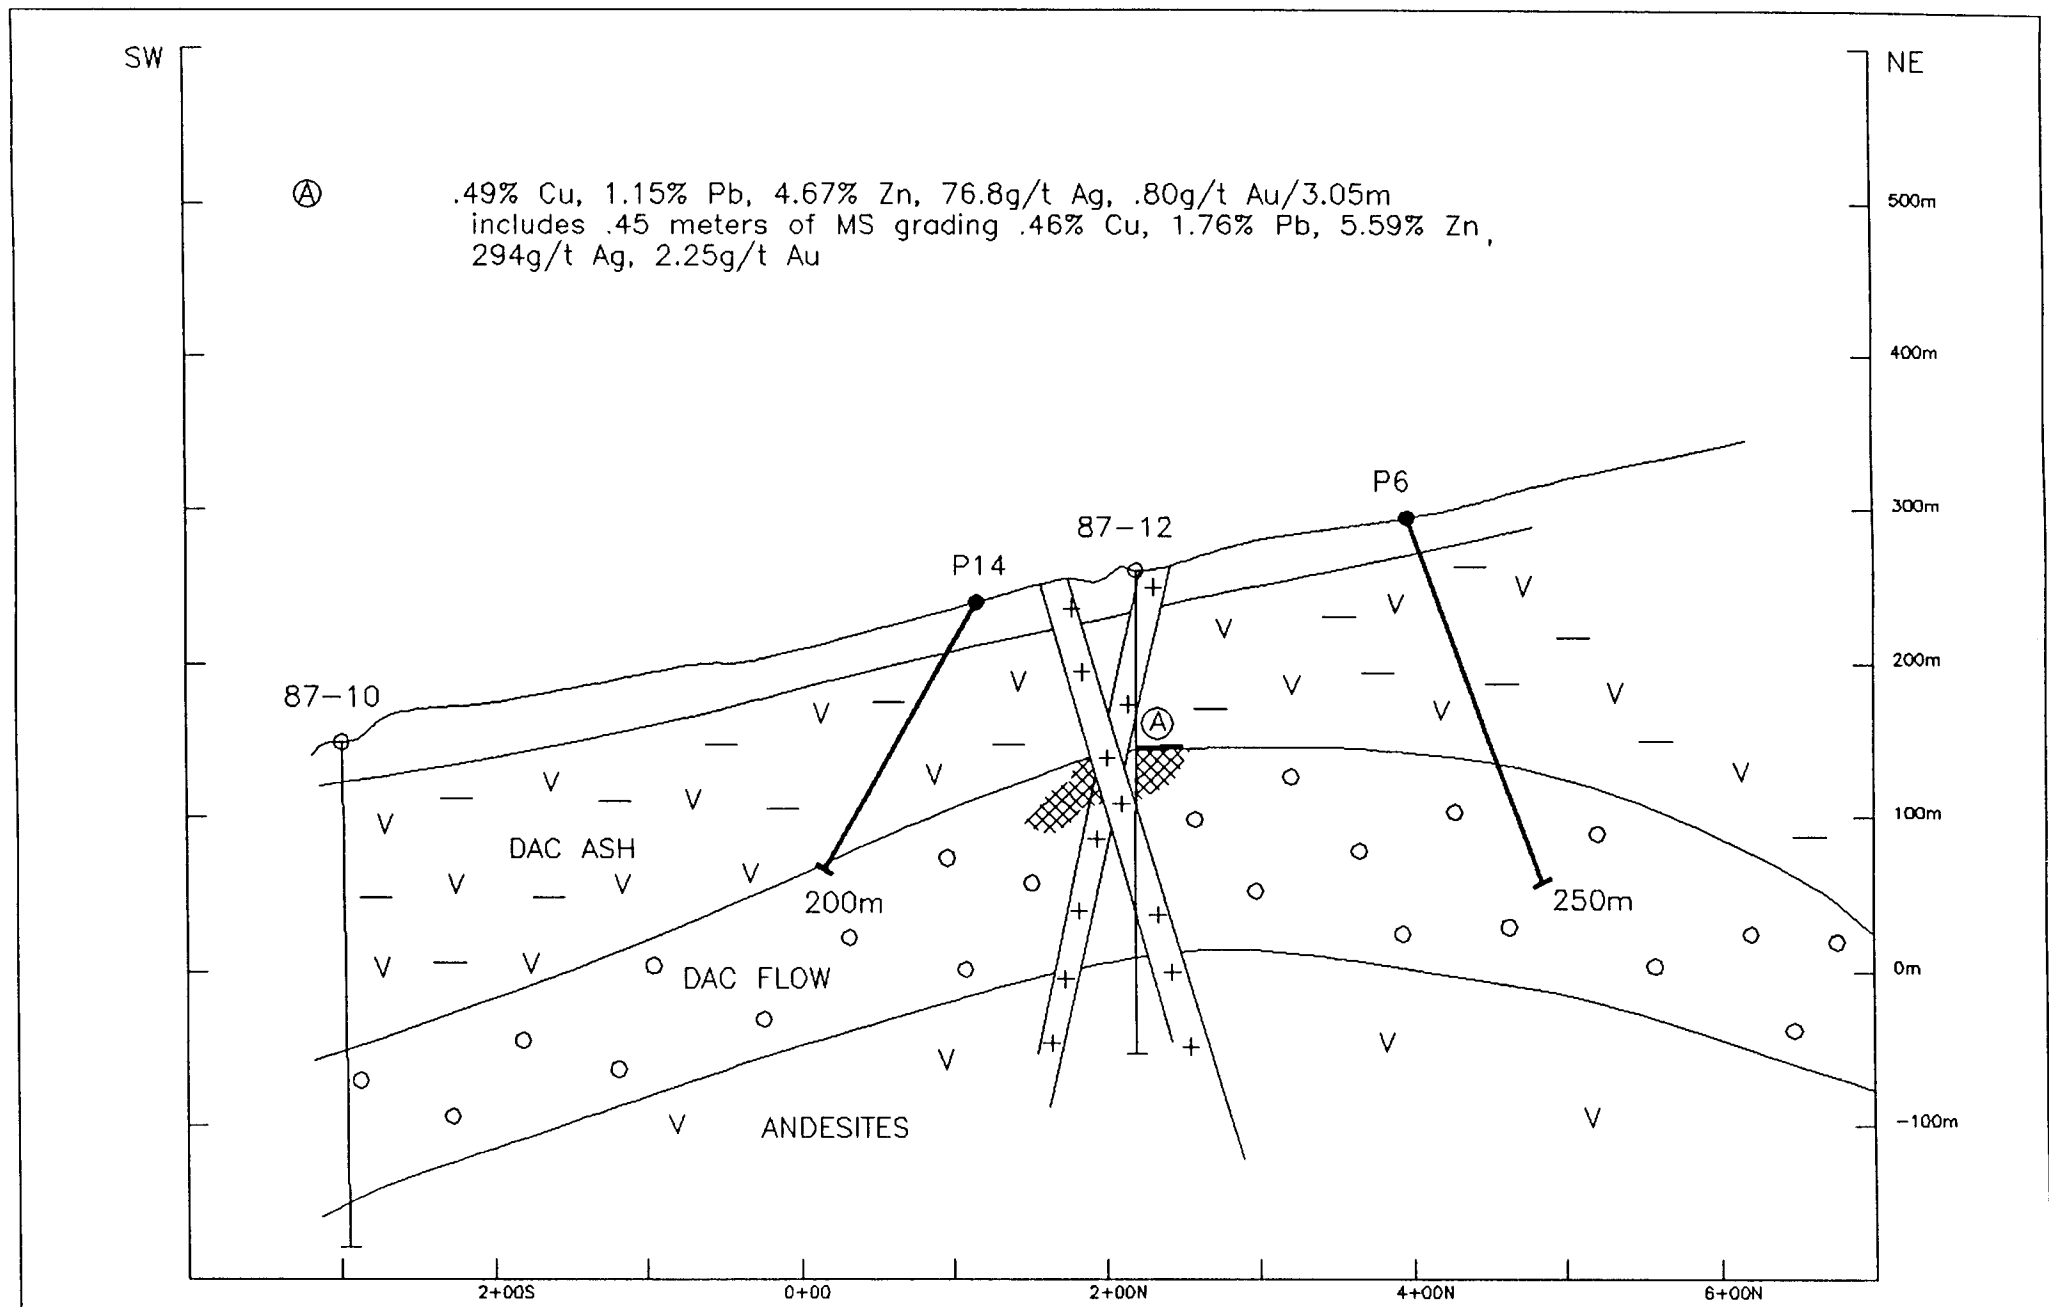

SECTION 92+20E (P6, P14)

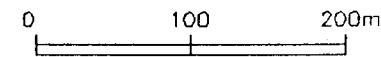


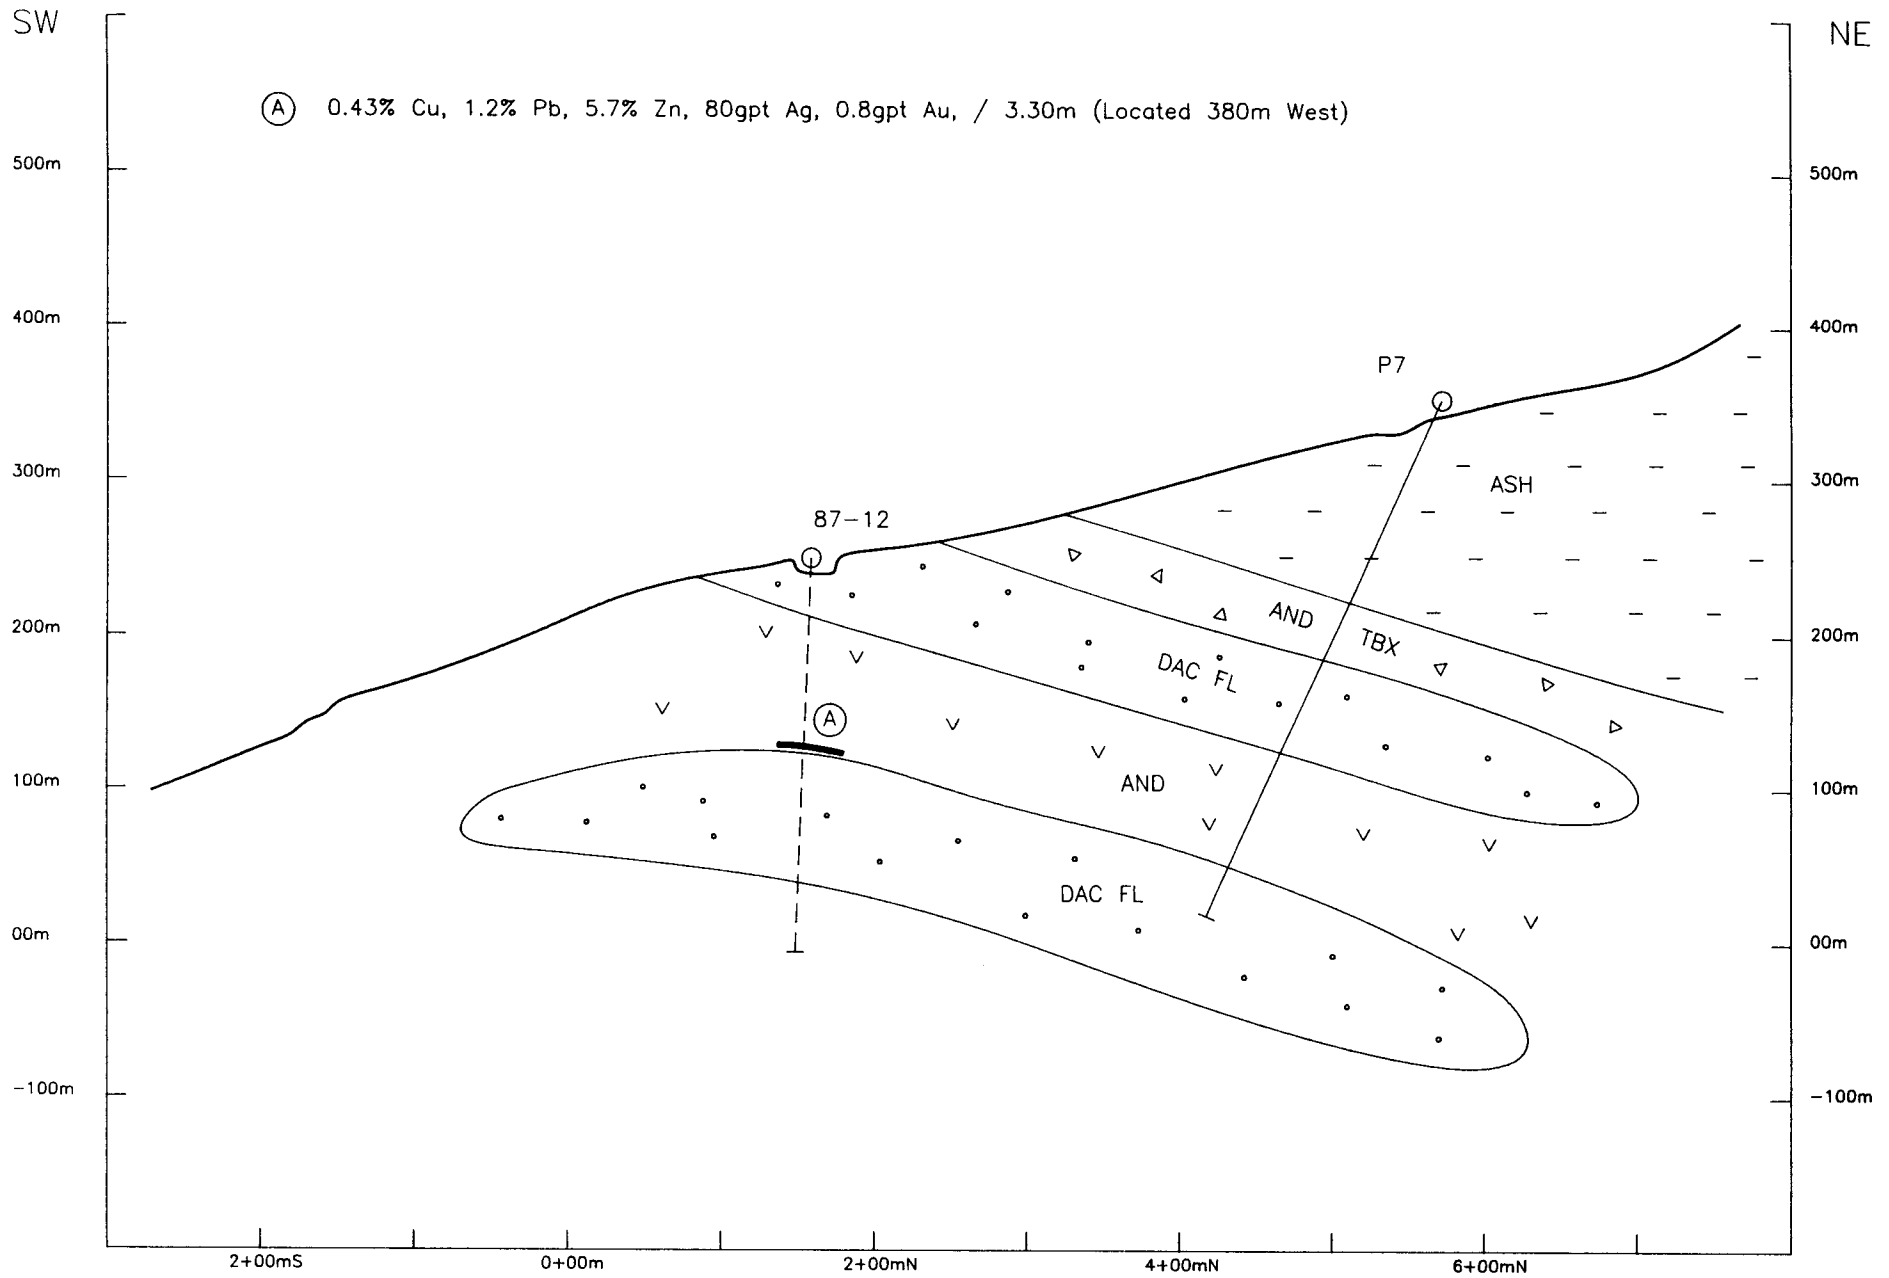

SW

NE

1986 IP anomaly

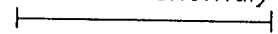

500m

400m

300m

200m

100m

0m

-100m

P8

DAC ASH

DAC ASH

ANDESITE

200m

2+00S


0+00

2+00N

4+00N


6+00N

SECTION 94+65E (P8)

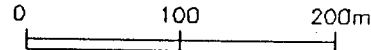



SW

NE

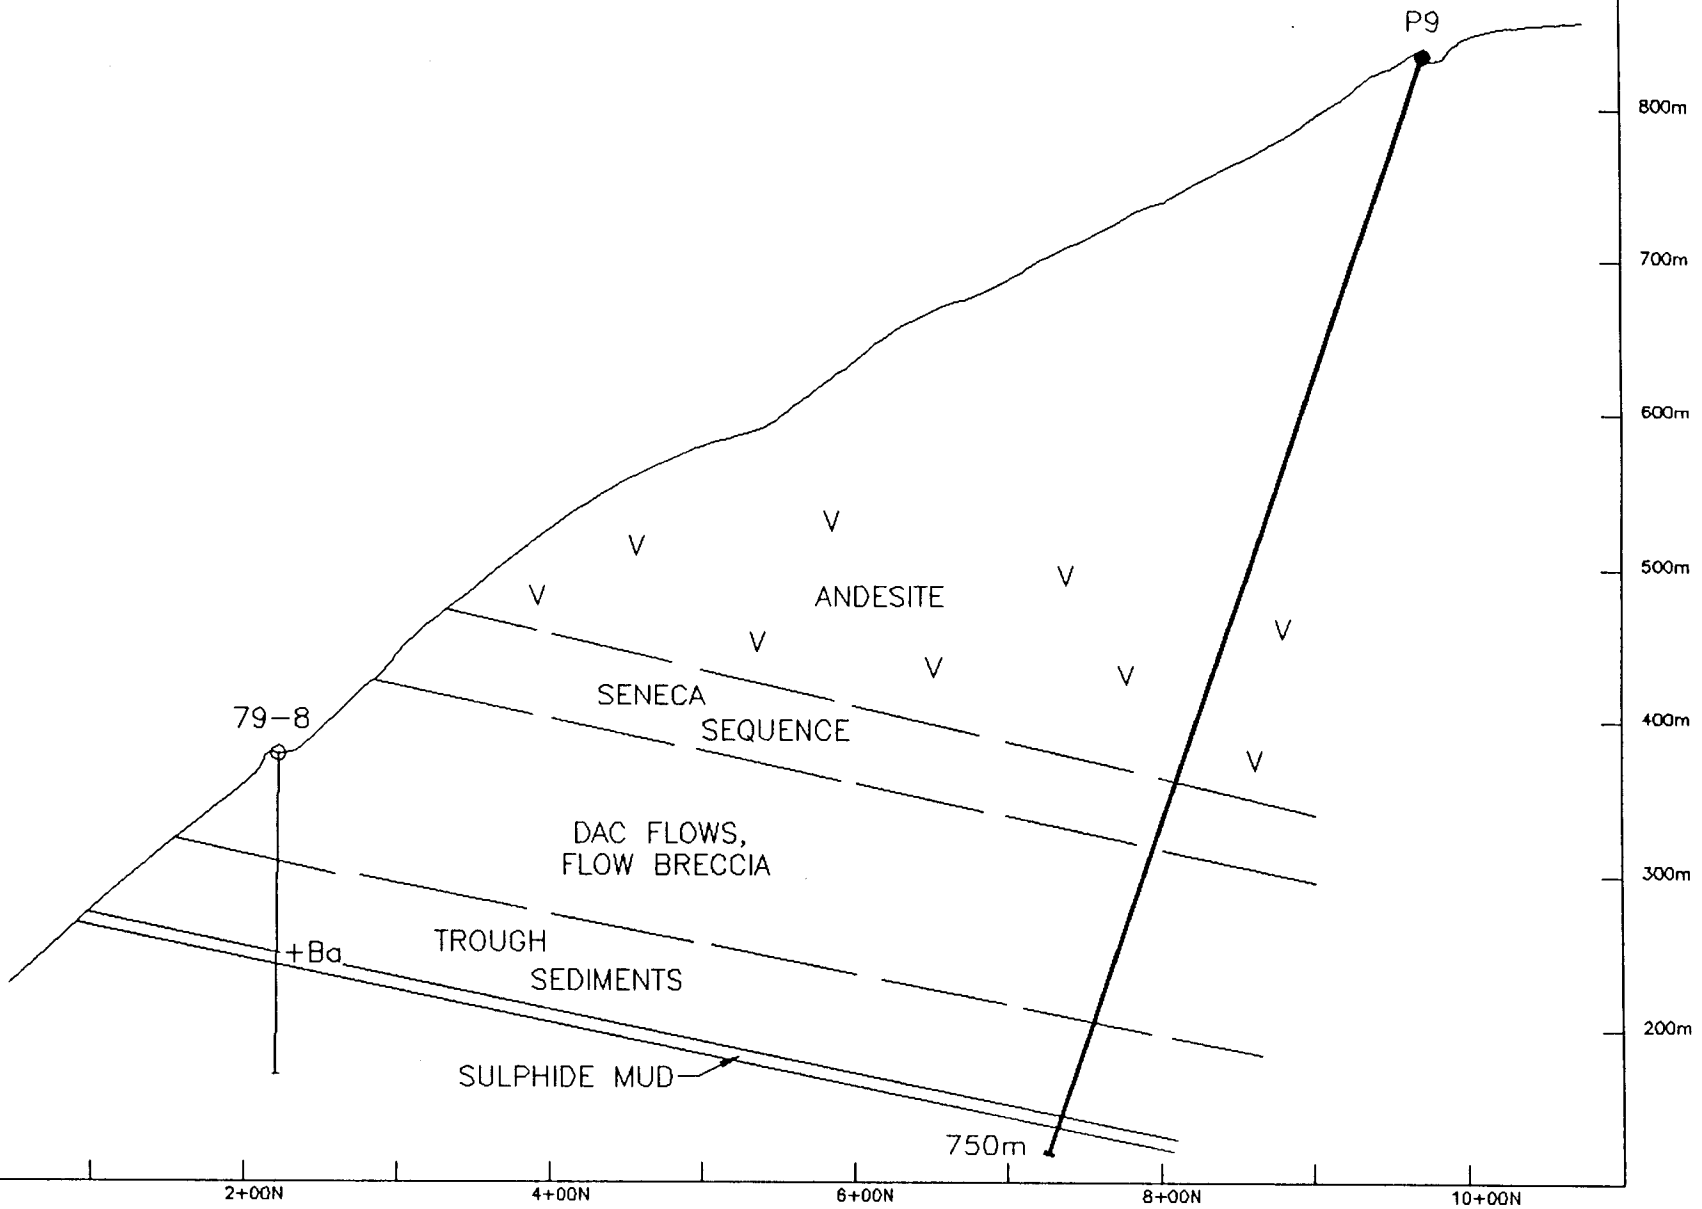


SECTION 5+00W (P9)

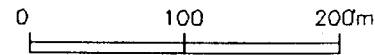

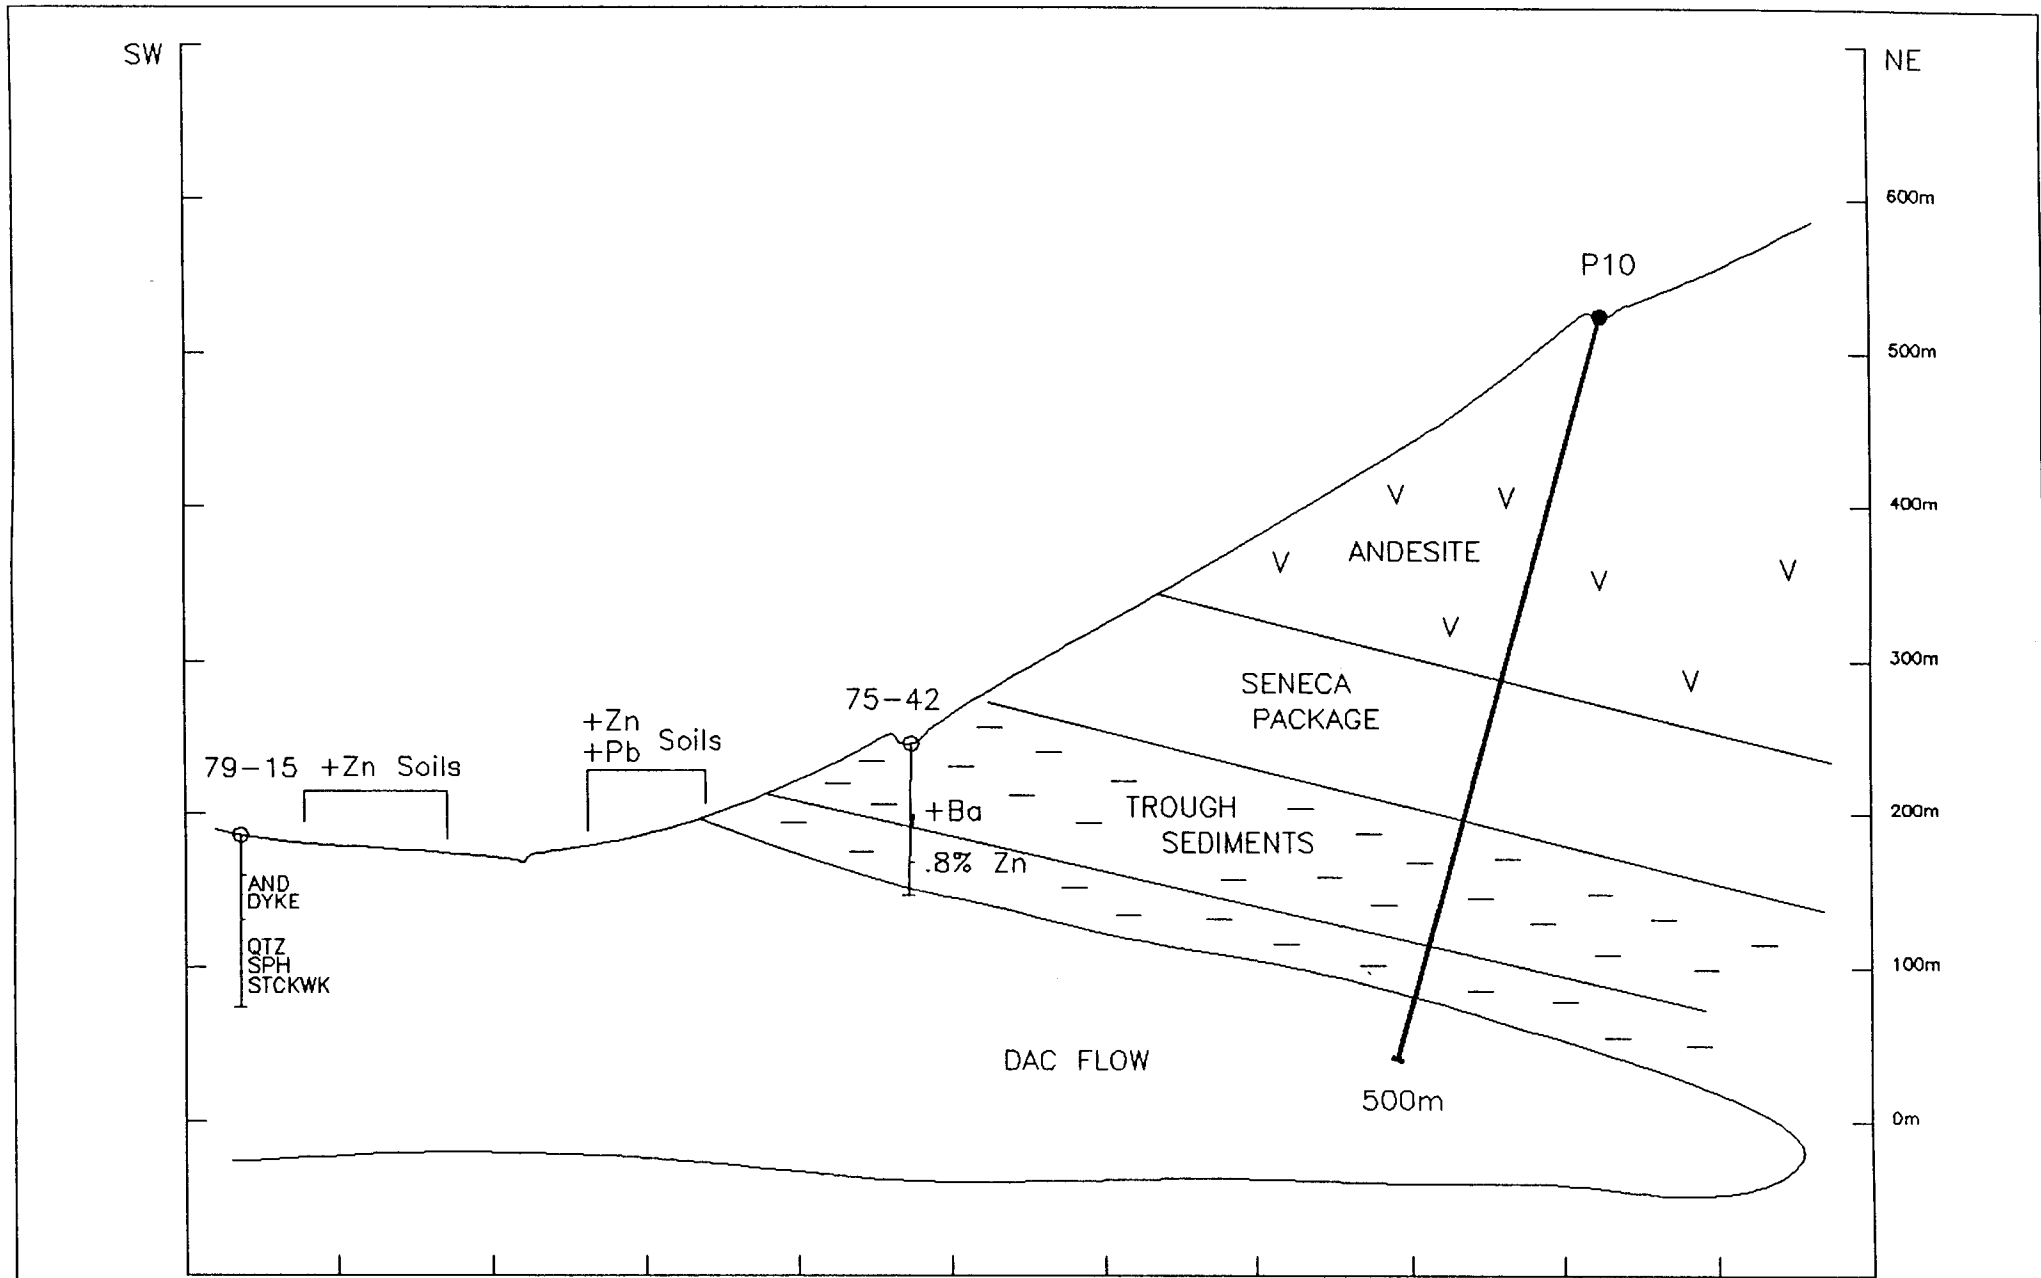

SECTION 7+00E (P10)

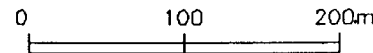

SW

NE

700m

600m

500m

400m

300m

200m

100m

P11

ANDESITE

79-3

50m

79-28

71-11

SENECA DEPOSIT  
SEQUENCE

FOOTWALL  
DACITE  
PYROCLASTICS

DAC FLOW

2+00S


0+00

2+00N


4+00N

6+00N


SECTION 3+20W (P11)

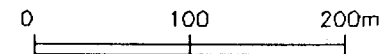



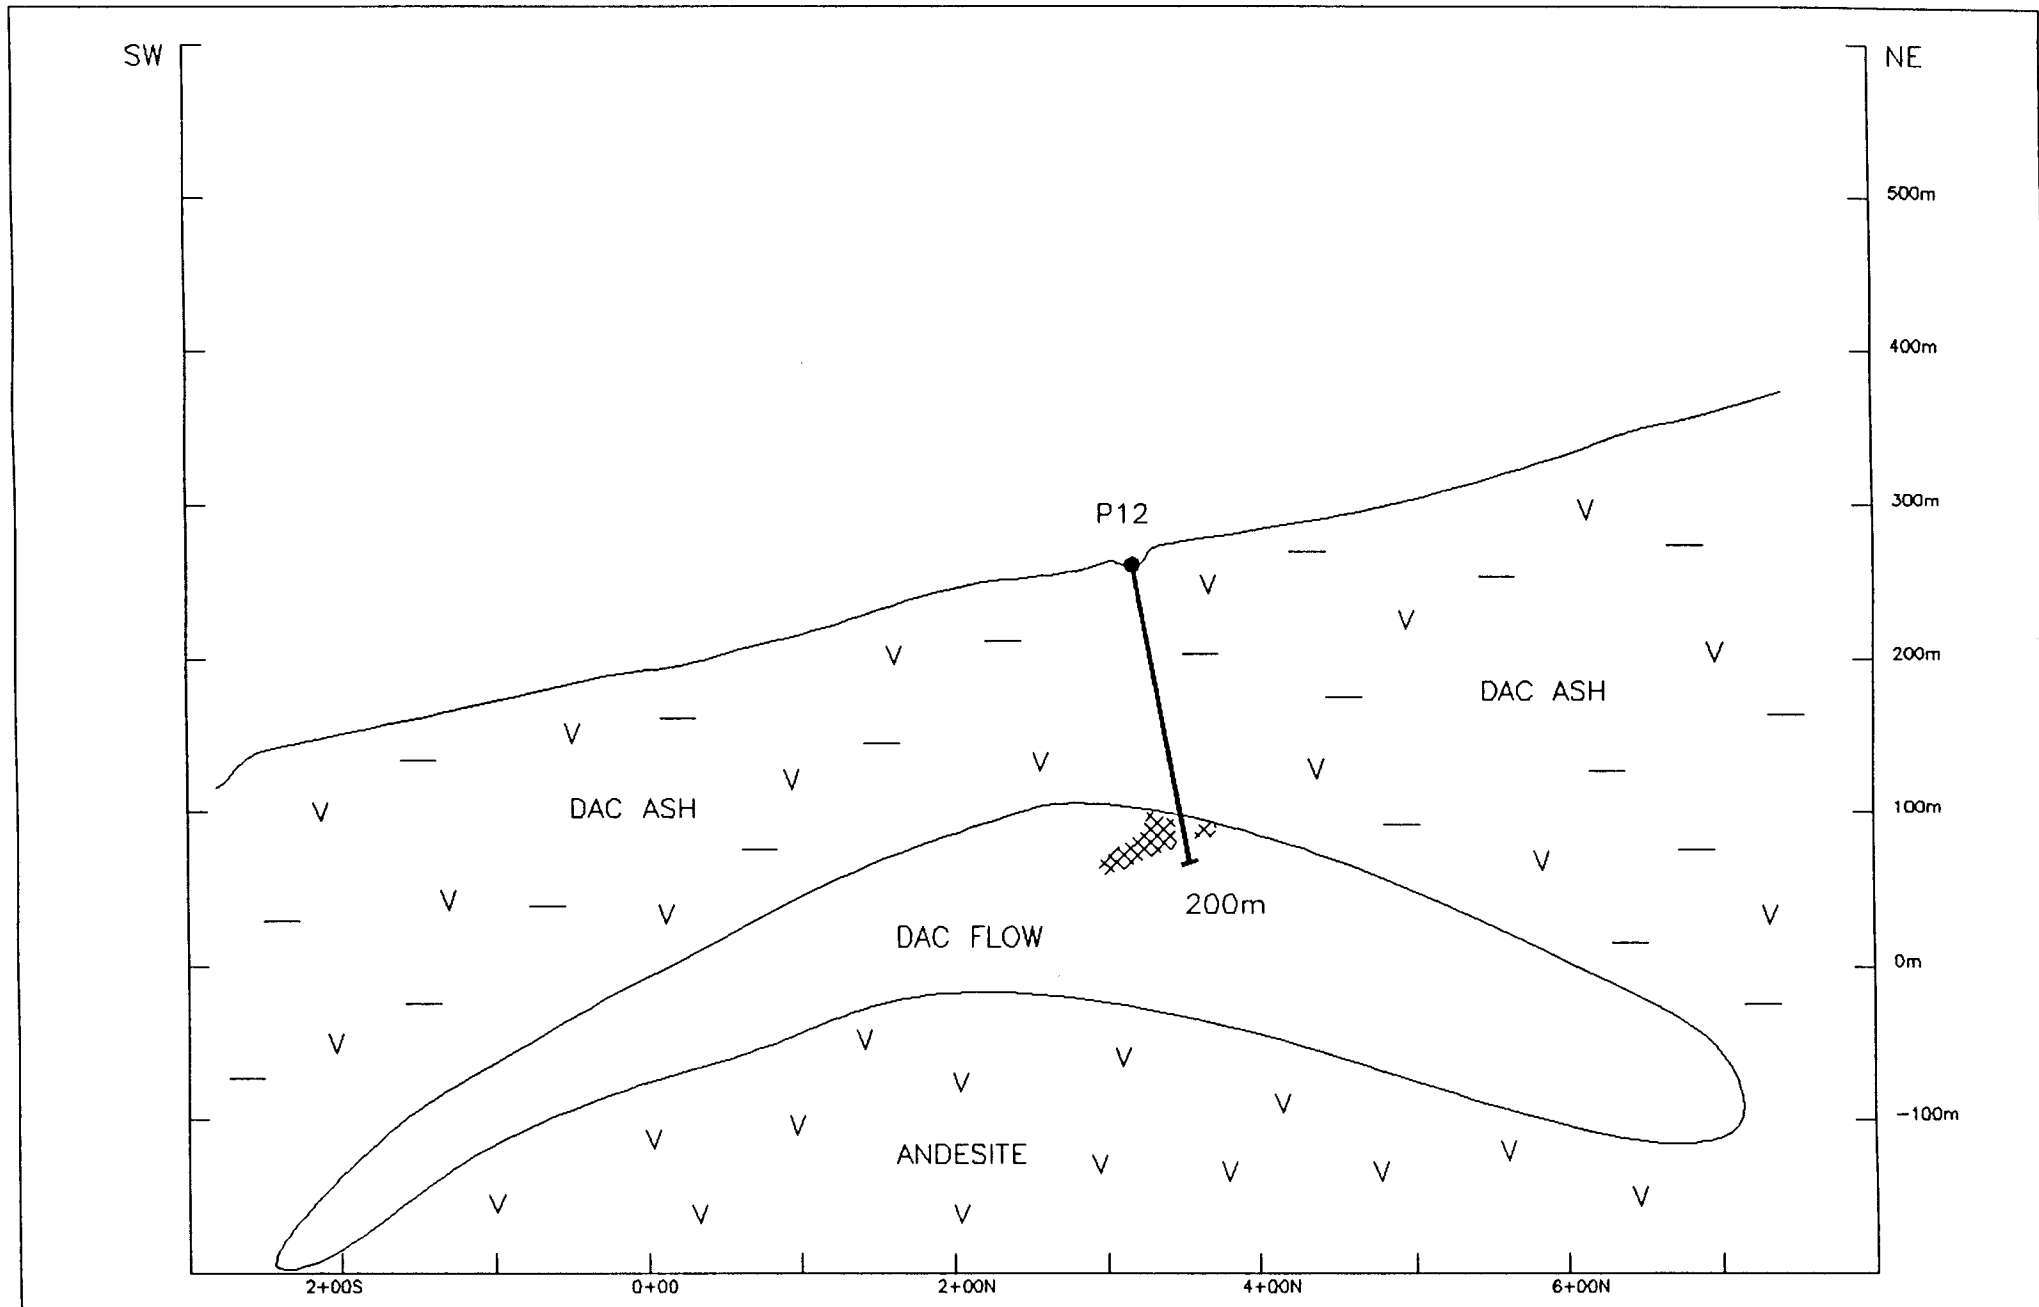

SECTION 90+00E (P12)

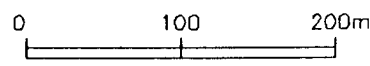

SW

NE

Ⓐ

1654 ppm Zn 500 metres to west in 79-10

500m

400m

300m

200m

100m

0m

-100m

+Cu,Pb,Zn  
Soils

P13

TROUGH SEDIMENTS

100m

DAC GMS

16+00S


14+00S


12+00S


10+00S

8+00S


SECTION 13+50E (P13)

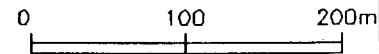

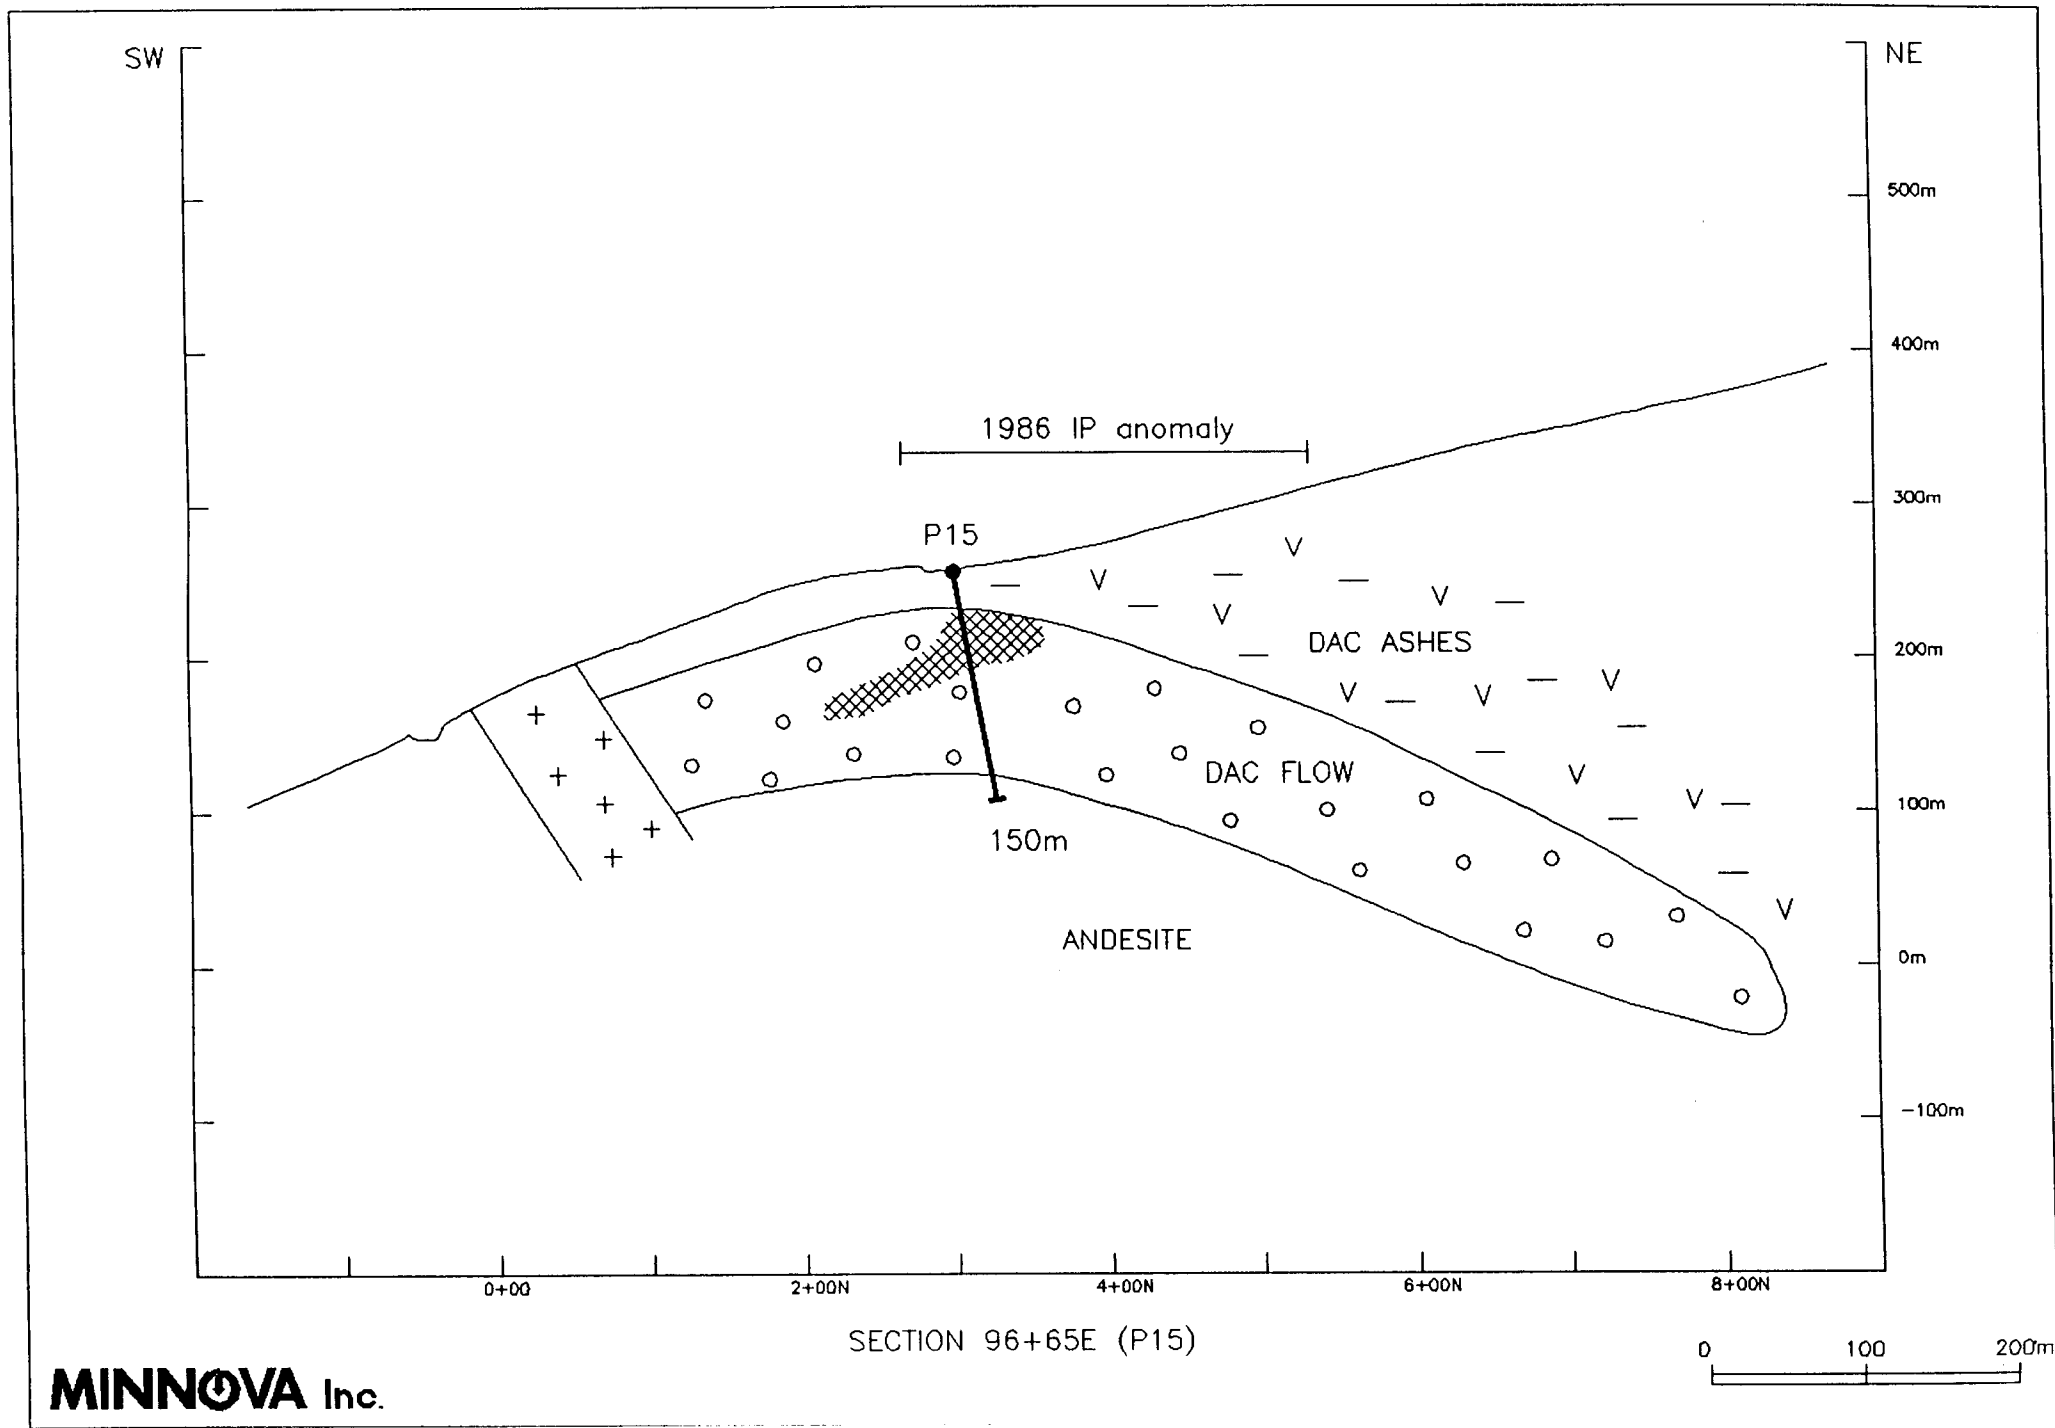

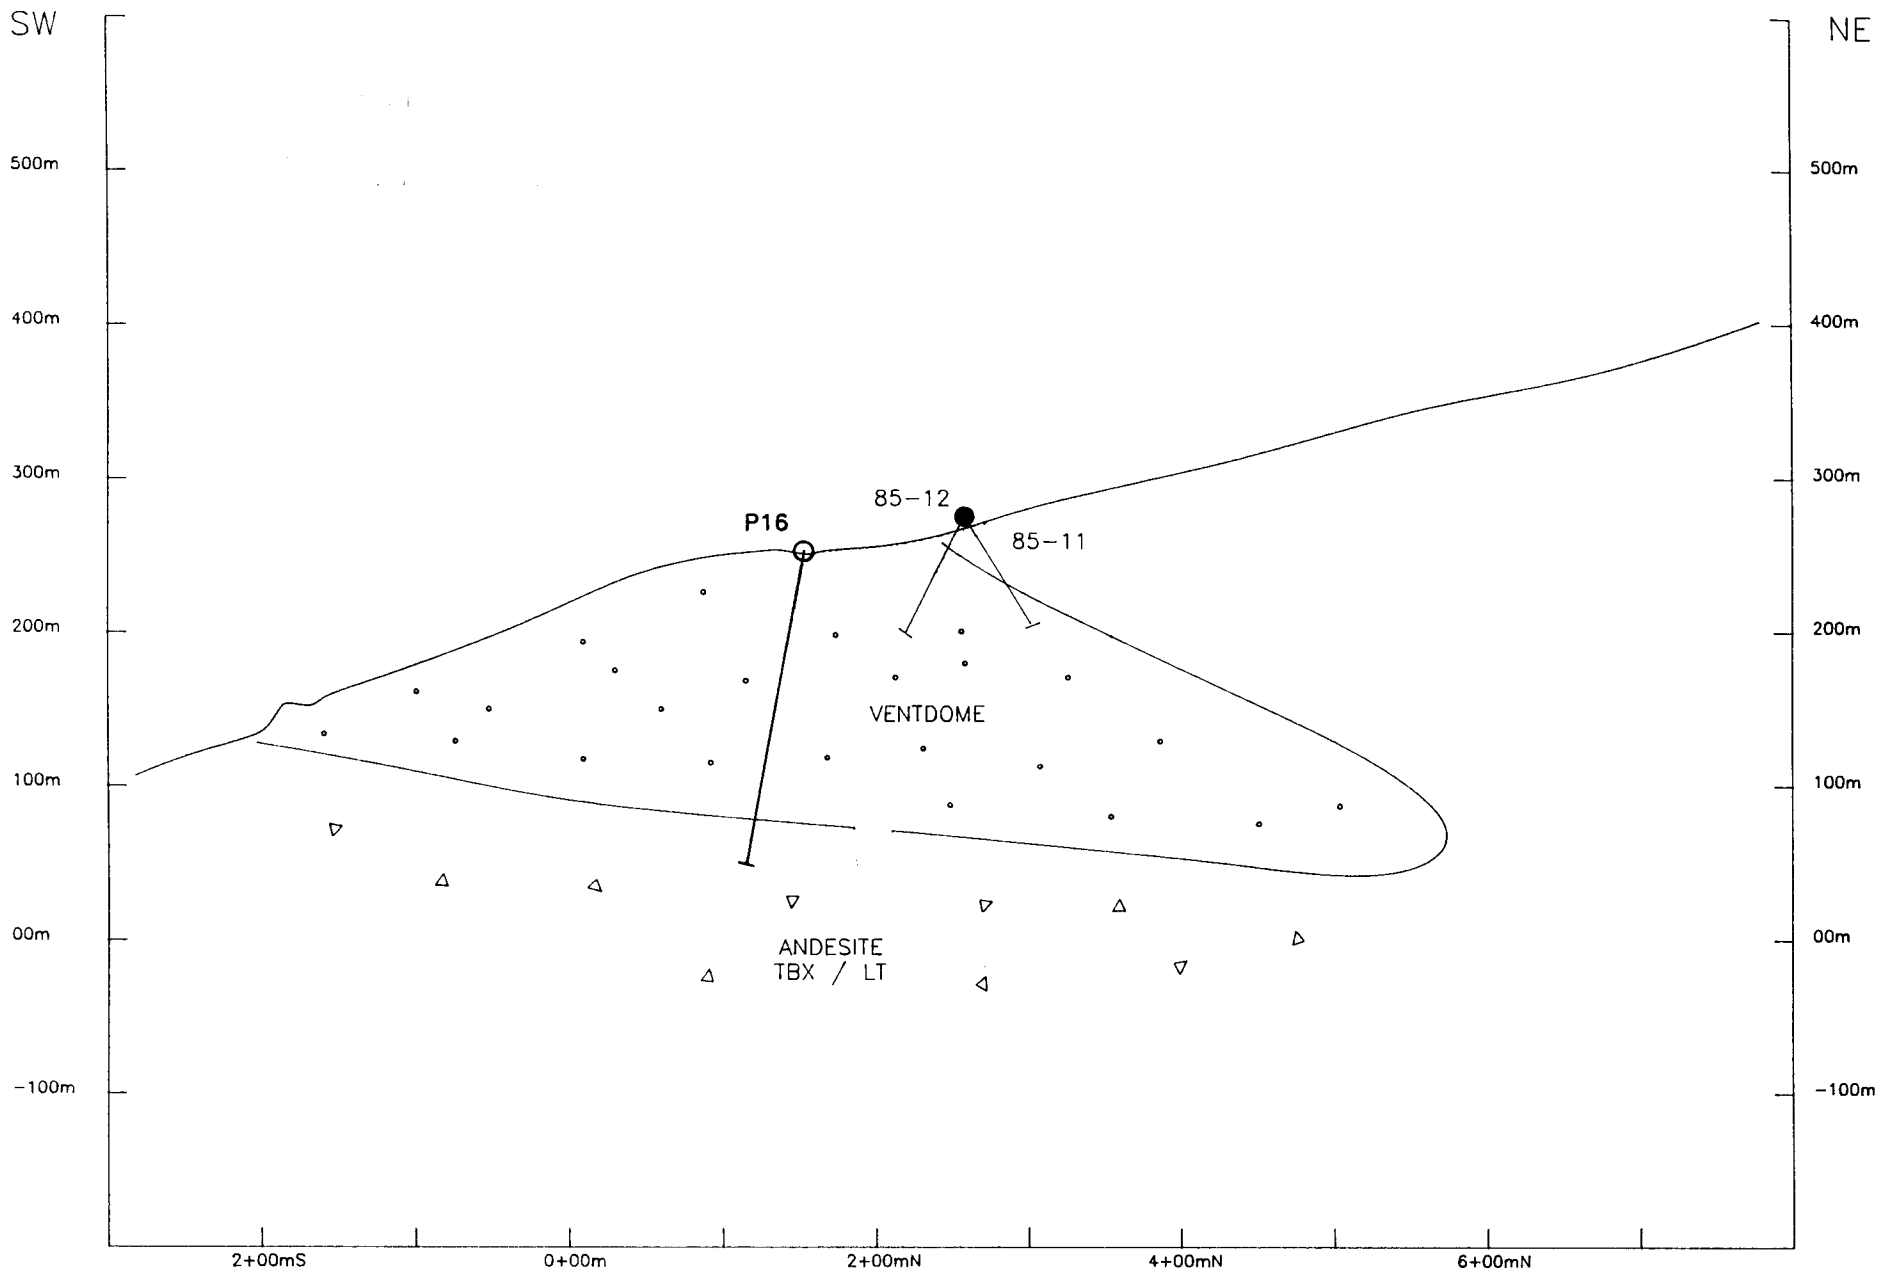

SECTION 101+87E (P16)

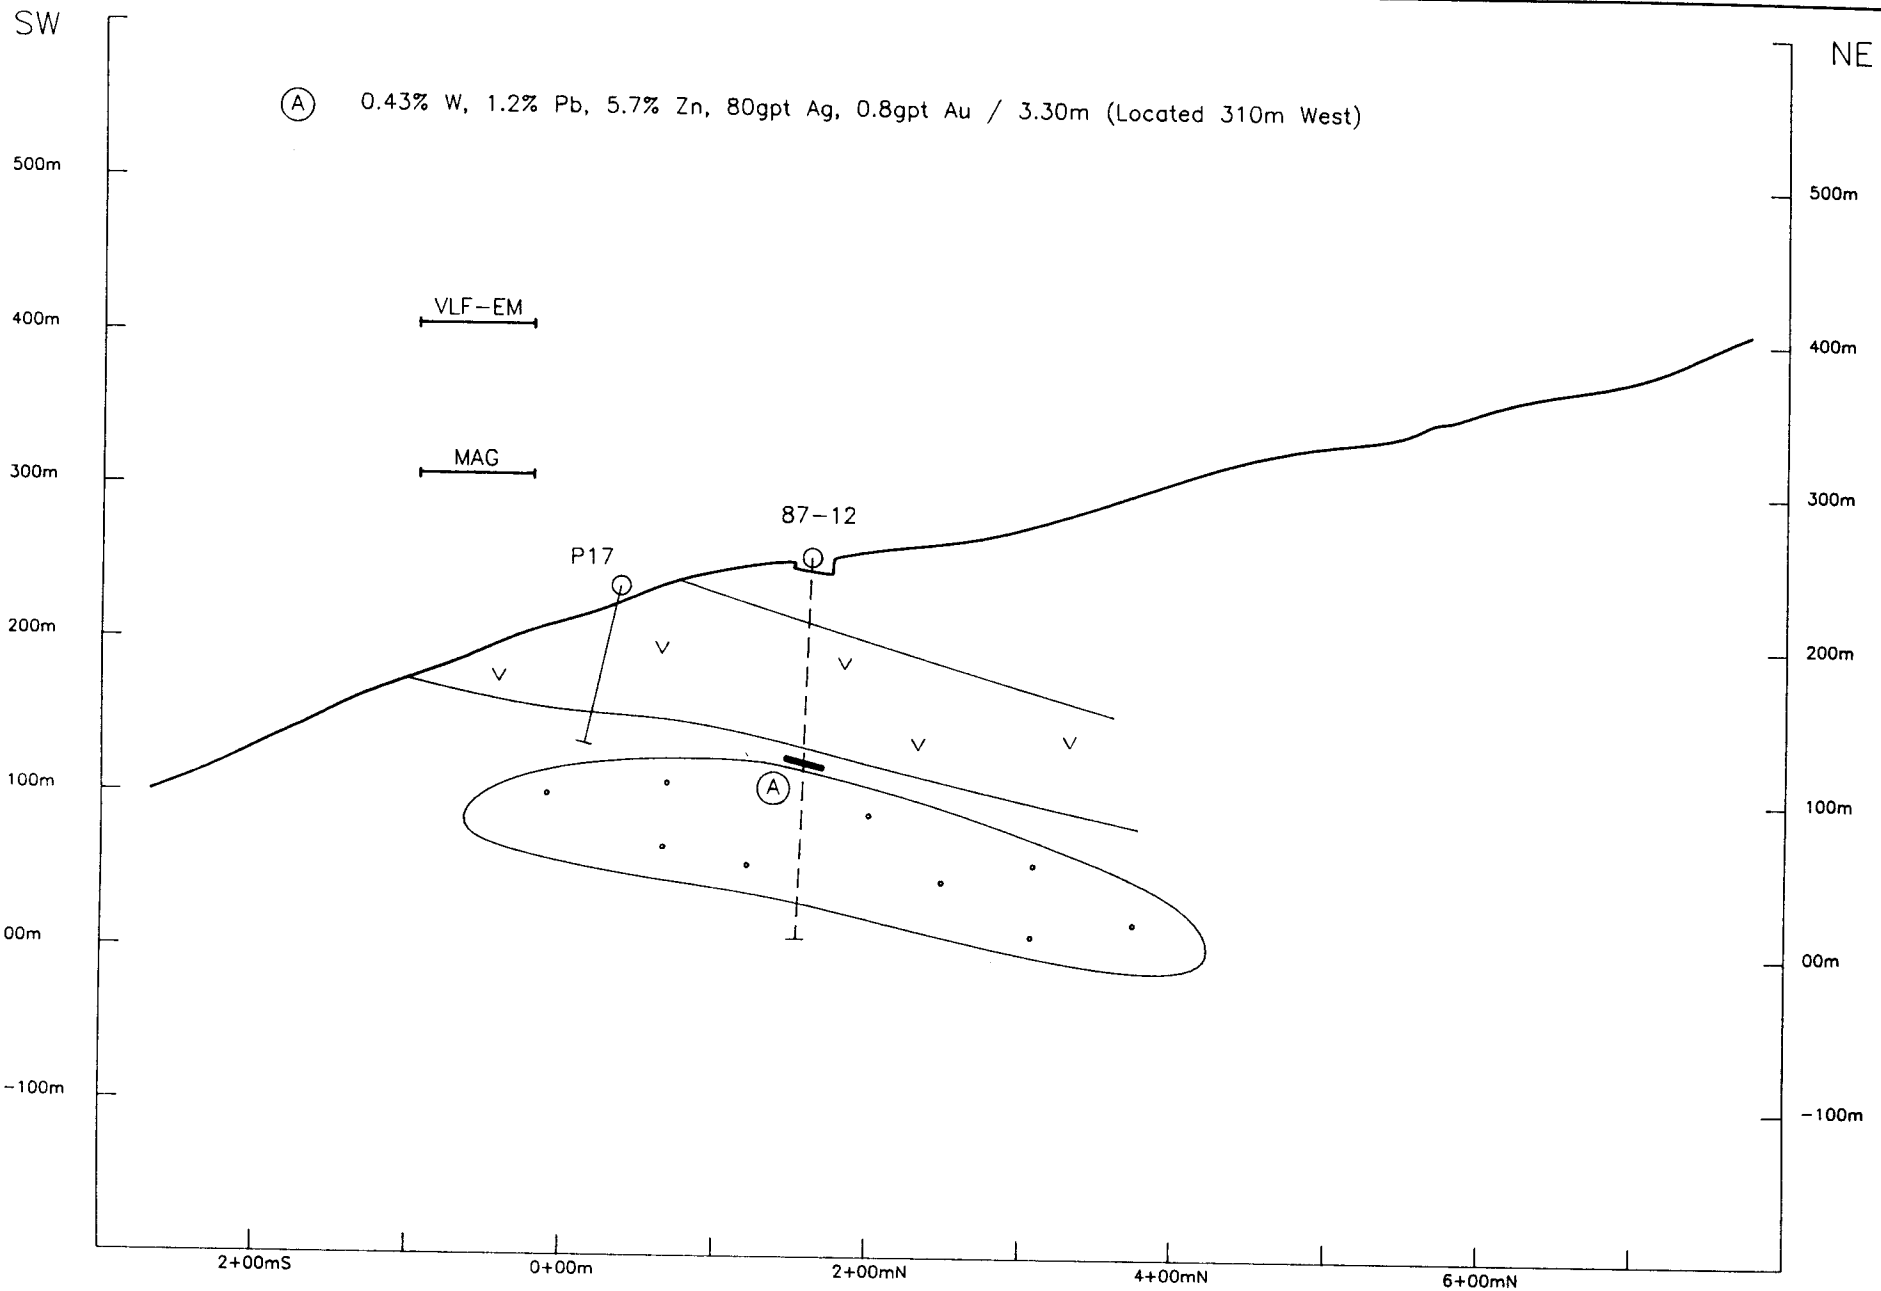

Section line for trough  
not

Order of drilling  
P1, 2, 3, 4, 5, 7, 15, 18, 16, 12, 14, 17, 16

Table 1. Proposed Diamond Drilling Holes - Seneca Property

Field

13 on the way out.  
What about P11?

| Hole # | Line | Strn.  | Azim.<br>(deg) | Dip<br>(deg)      | Length | Cost           | Target   |  |
|--------|------|--------|----------------|-------------------|--------|----------------|----------|--|
| S91-02 | P1   | 2+40E  | 2+50N          | 050               | -60    | 300.2<br>300 m | \$19,500 | A 200 meter step-out on 85-3 MS intercept (10.1% Zn, .17 opt Au/0.64 m) situated above a 20 meter pyrite/gypsum stockwork sulphide system<br><i>expect about 210m-245m</i>                                     |
| 85-7   | P2   | 1+50E  | 3+00S          | 230               | -80    | 170.1<br>100 m | \$8,500  | Will test zinc bearing sediments stratigraphically below the Seneca deposit. This hole is an extension of 85-7 which was terminated in Qtz-Py-Zn mineralization<br><i>we already 354ft Trough stratigraphy</i> |
|        | P3   | 4+35E  | 10+20S         | 050               | -80    | 159.7<br>100 m | \$6,500  | P3 will test the SE strike extension of zinc bearing turbidites and a coincident barium soil anomaly.<br><i>NO Si! act Dome, 2600 ft water line.</i>   |
|        | P4   | 5+00W  | 4+50S          | 230               | -80    | 149.7<br>150 m | \$9,750  | Will test a Cu-Pb-Ba soil anomaly within the zinc exhalite sediment package 400 m east of previous drilling.<br><i>Collar into Dome. 1600 ft water line</i>  |
|        | P5   | 3+10W  | 1+20S          | 230               | -80    | 150 m          | \$9,750  | Will test zinc bearing sediments situated stratigraphically below Seneca and in the vicinity of a postulated synvolcanic fault.  |
| Vent   | P6   | 92+15E | 4+00N          | 050               | -70    | 250 m          | \$16,250 | P6 will follow up MS intercept in 87-12, 250 m North   |
| S91-05 | P7   | 96+00E | 5+70N          | 050<br>230        | -80    | 275.8<br>350 m | \$22,750 | P7 will test an IP anomaly west of S-90-01<br><i>change shown</i>  |
| S91-07 | P8   | 94+65E | 2+20N          | 050<br>-80<br>-75 | -80    | 200 m<br>211.8 | \$13,000 | P8 will test the east strike extension (towards the Vent) of massive sulphides intersected in 87-12.   |
|        | P9   | 8+00W  | 9+00N          | 230               | -70    | 750 m          | \$48,750 | P9 will test the Seneca deposit sequence 500 m west of the pit and 500 m downdip. This hole will also test the downdip potential of barite enriched Trough sediments.  |

S91-02  
shut down  
25m doc Lith  
LAP 10 ft.

#1-2705

10490 34042

1600 ft water line

Trough 1100 ft

slating  
route

97-03  
Need new FS + BS

S91-04  
0+25E  
sect

670

sect  
1700W

230 2135

Vent

S91-05

S91-07

Next program

16 after 7?

Find a casing in pit area to drive deep & test trough.

**Table 1. Proposed Diamond Drilling Holes – Seneca Property (cont.)**

*Field*

| Hole #                                     | Line    | Stn.   | Azim.                 | Dip                   | Length | Cost     | Target   |
|--|---------|--------|-----------------------|-----------------------|--------|----------|--|
|  |         |        | (deg)                 | (deg)                 |        |          |  |
| P10<br><i>Next program</i>                 | 8+50W   | 1+50S  | 230                   | -75                   | 600 m  | \$32,500 | P10 will test the Seneca deposit sequence 750 m E and will also test barite enriched Trough seds, 300 meters down dip.           |
| P11<br><i>other side of offset fault.</i>  | 00+00   | 4+00N  | 230                   | -80                   | 50 m   | \$3,250  | P11 will test postulated occurrence of the Seneca deposit sequence stratigraphically above previous drilling 300 m W of the pit. |
| <i>vent</i> P12                            | 90+00E  | 3+10N  | 050 ✓                 | -80 ✓                 | 200 m  | \$13,000 | P12 is contingent on results of P6 and P8 and will test massive sulphides in 87-12, 250 m to the west.                           |
| <i>Trough</i> P13                          | 7+10E   | 11+00S | 230                   | -85                   | 100 m  | \$6,500  | P13 will test a Cu, Pb and Zn anomaly in Trough sediments more than 500 meters SE of all previous drilling.                      |
| <i>do after 3, 4, 5</i><br><i>vent</i> P14 | 91+85E  | 1+30N  | 230                   | <del>-75</del><br>-80 | 200 m  | \$13,000 | P14 will test the continuity of massive sulphides intercepted in 87-12, 200 m S.   |
| <i>59-06</i> P15                           | 97+00E  | 1+80N  | <del>230</del><br>050 | <del>-80</del><br>-80 | 200 m  | \$13,000 | P15 will test the <u>Vent</u> alteration pipe 300 m west and continue testing the 87-12 MS horizon 525 m E.                      |
| P16  | 101+87E | 0+15S  | 230                   | -80                   | 200 m  | \$13,000 | P16 tests Vent dome/And-white fragment breccia contact   |
| P17  | 95+35E  | 0+35S  | 230                   | <del>-80</del><br>-85 | 100 m  | \$6,500  | P17 will test the lower Vent horizon and a coincident Mag/VLF anomaly  |

*13+60E  
~0+80S*

*felsic lith in AND-  
below NEV RHY.*

*Also  
r/ggd work.*

**Total 4000 m 260,000**

Costs include direct drilling costs, assays, salaries @ \$65/m

LTH with

LT Cap T

FL Flow

FL/Bx flow Bx

BLT Black & lopilli Tubl

Black  
20% 76cm

2-6cm lopilli  
22cm ash tubl.

DAC

AND

RHY

DAS

FHPD + FPD orange  
feldspar, phosph, chylse  
hornblende

QFPD pink.

Alt

Small letters  
↓

W wead

M nod

S shoy

I antens

epi epidote

chl

ser

Si silica

microcalcite  
Flipped 25%

py  
cp  
sph

SEKWK

MS 295%

Chemex  
Assay & Geochem.

Mu-en

LITHOS + ppm  
geochem