


Dec. 17/99



LEGEND

- River/ Stream: Blue dashed line
- Lake: Blue outline
- Drill Hole 1980: Red circle
- Drill Hole 1981: Red triangle
- Drill Hole 1988: Red square
- Road - rough: Dashed line
- Trench: TR 1 (Orange dashed line)
- Swamp: Tree symbol
- Marsh: Plant symbol
- Contour, index: Solid line
- Contour, intermediate: Dashed line
- Intrusive (Interpreted) from geophys.: Yellow cross-hatch pattern
- Interpreted Mag anomaly: Red line
- Thrust Fault: Black line with triangles

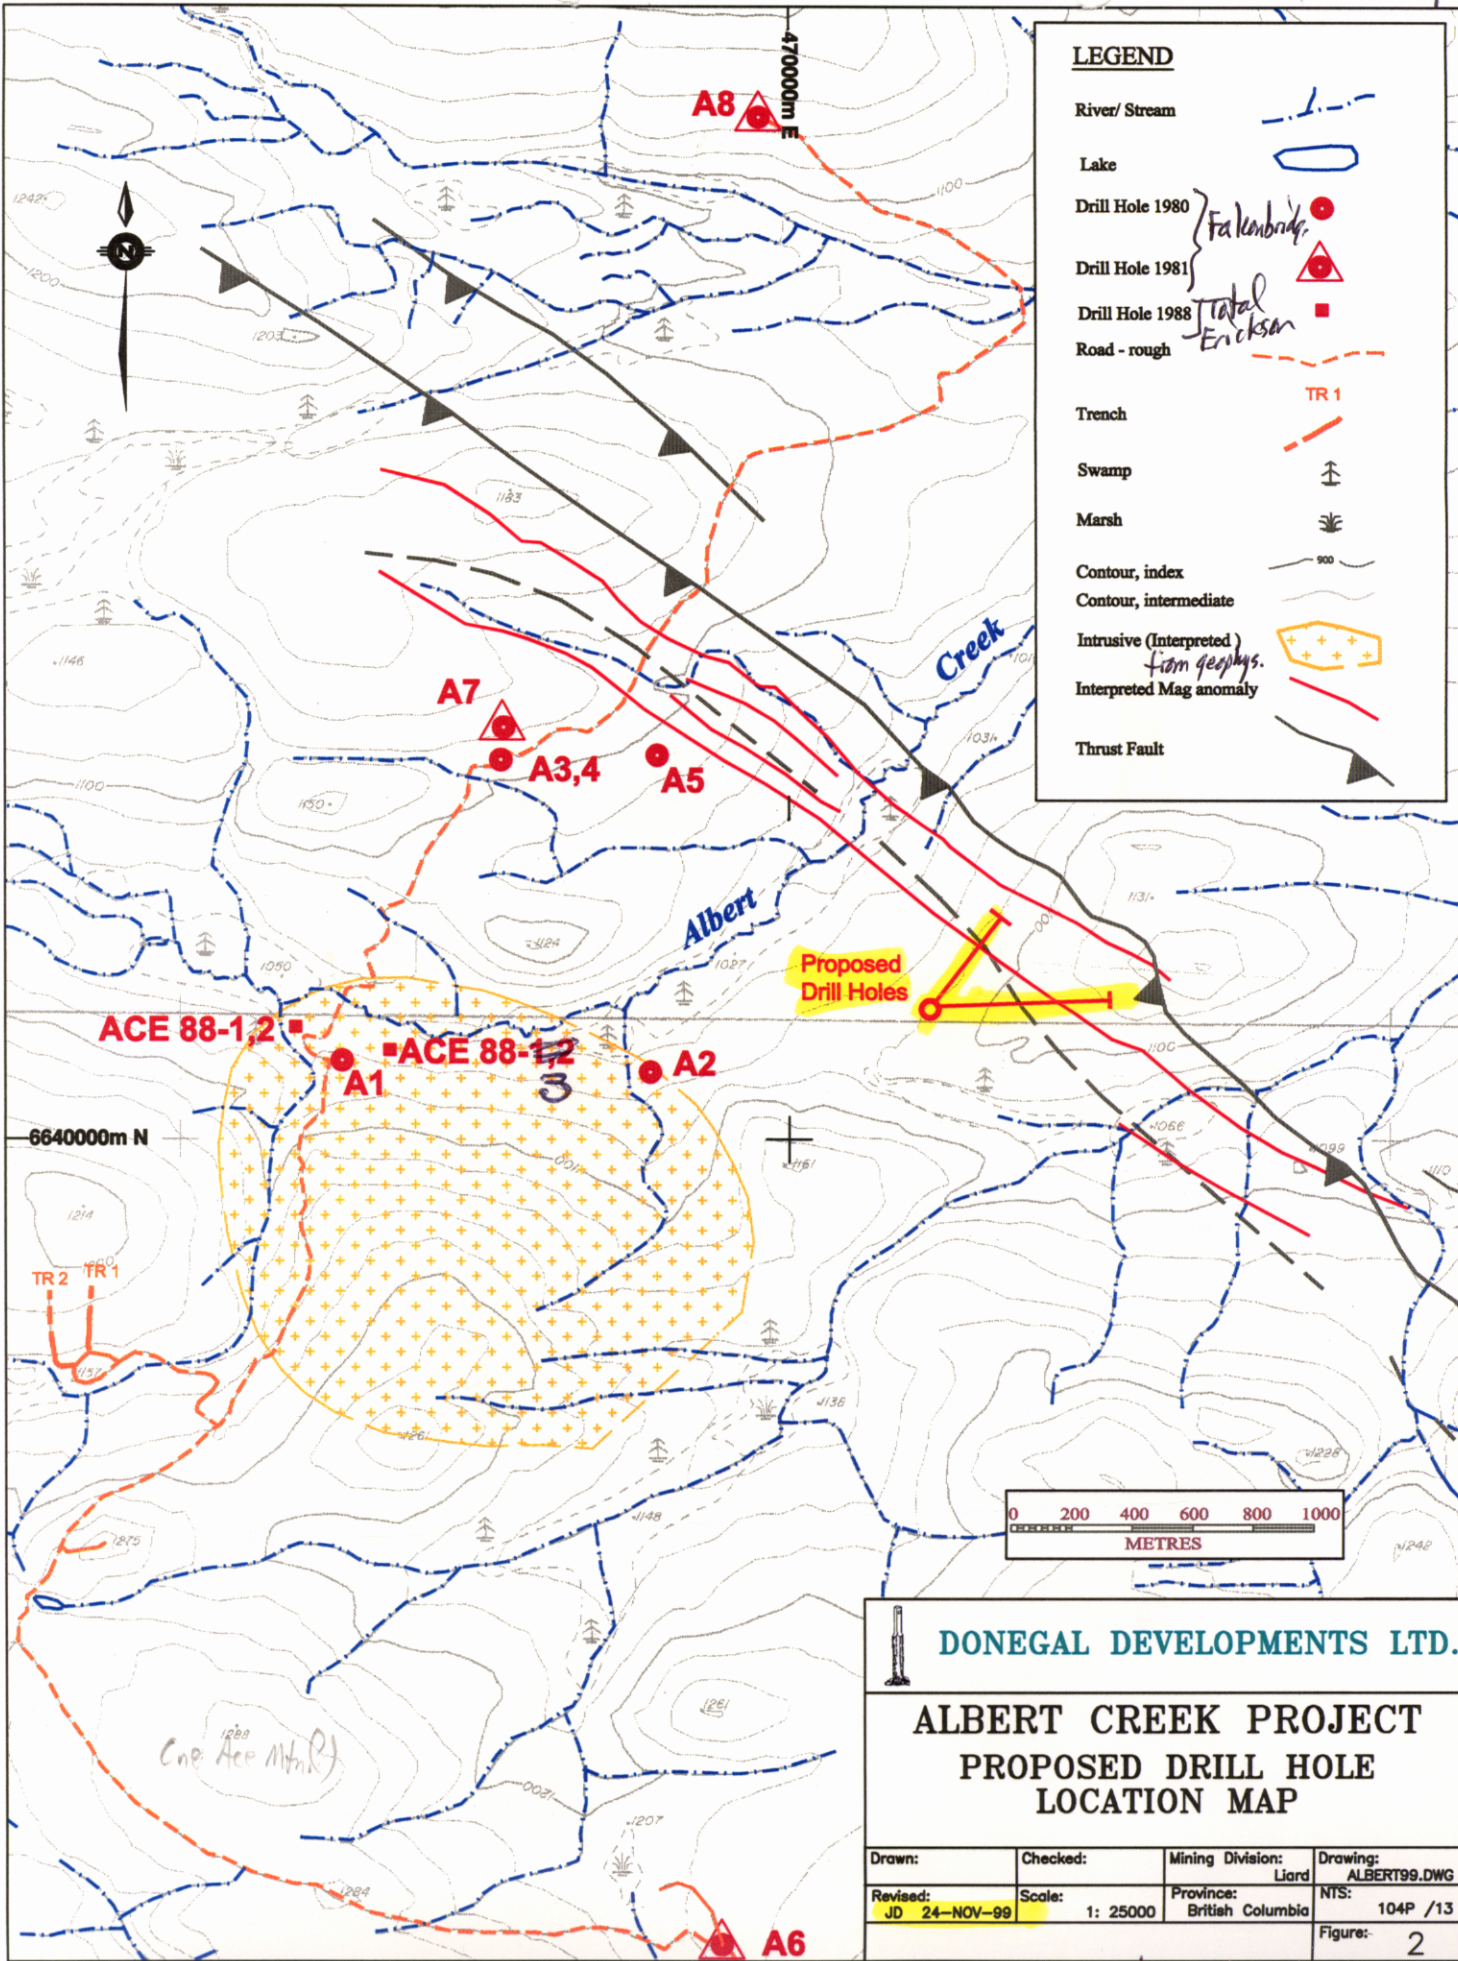

DONEGAL DEVELOPMENTS LTD.

**ALBERT CREEK PROJECT
PROPOSED DRILL HOLE
LOCATION MAP**

Drawn:	Checked:	Mining Division:	Drawing:
Revised:	Scale:	Province:	NTS:
JD 24-NOV-99	1: 25000	British Columbia	104P /13
			Figure: 2

From: Shamus Young: Conc. Loran Mines