


HW + NEX

OG 36

OBL #36

Ward

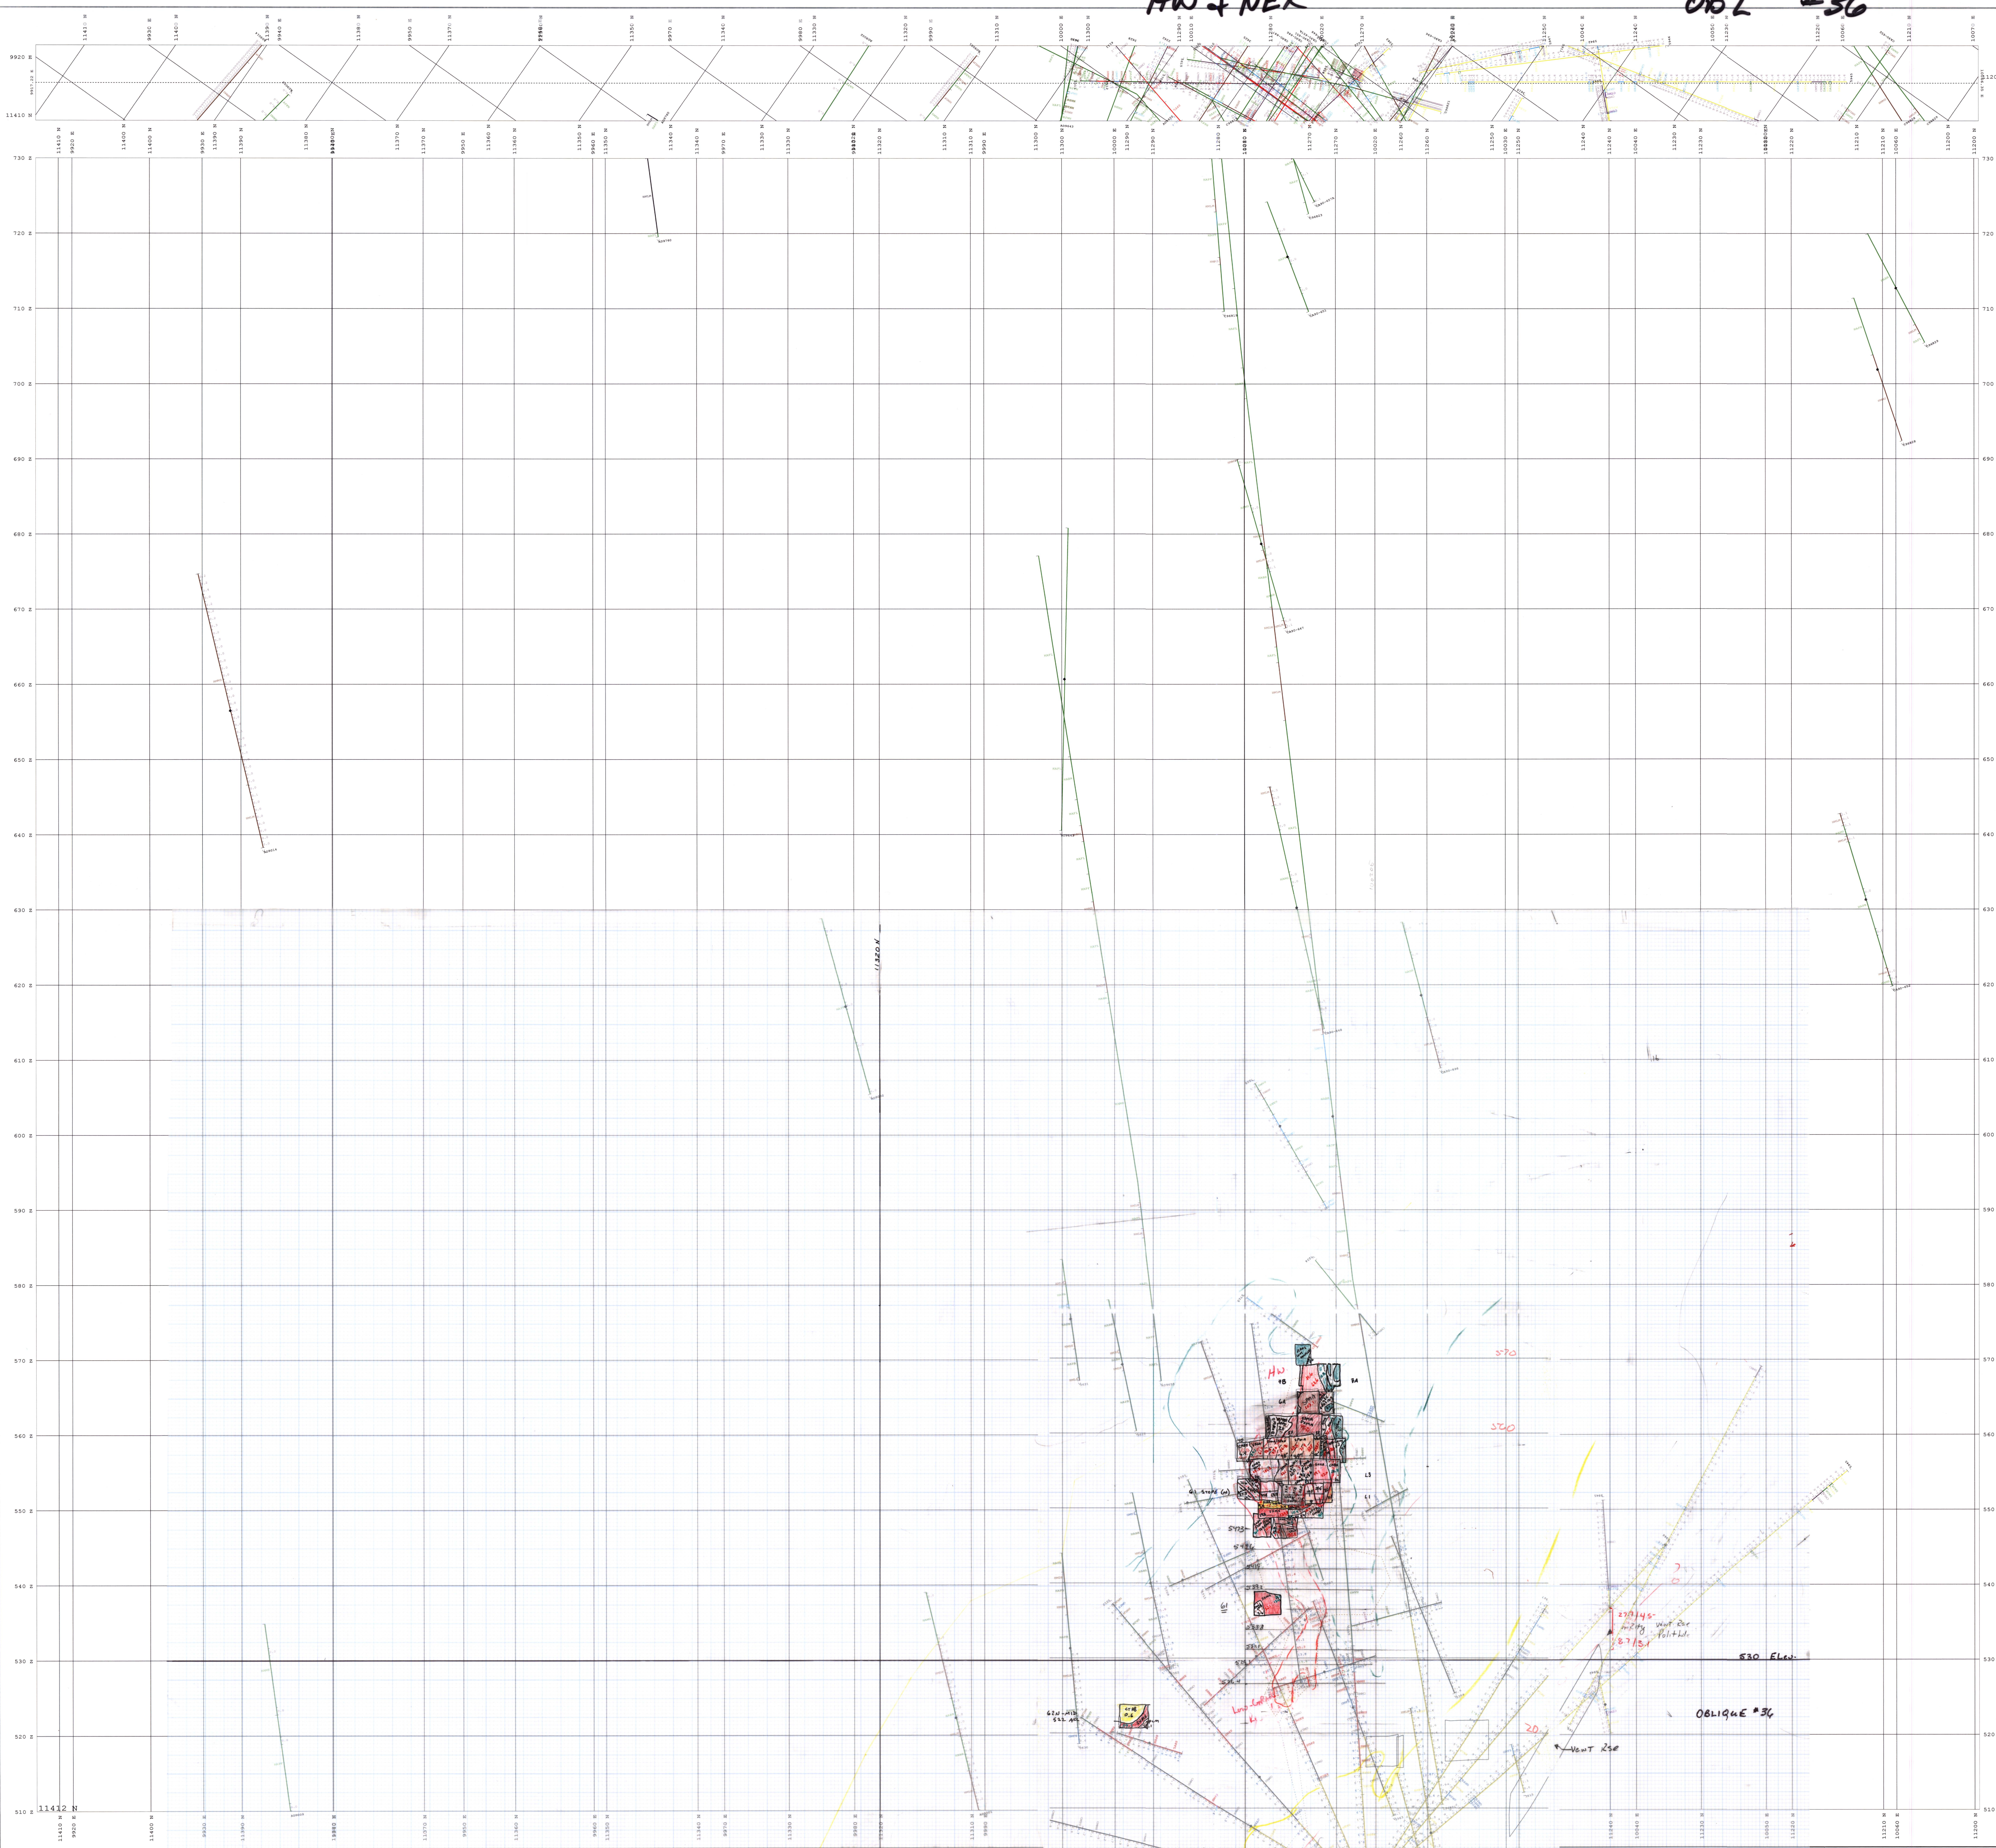



Eskey Creek Mine  
 Oblique Section 36  
 Looking Northeast

26  
 27  
 28