

1049

A	N
<input checked="" type="checkbox"/>	<input checked="" type="checkbox"/>
W.S.H.	
L.E.D.	
E.C.J.	
R.W.B.	
J.L.K.	
E.L.D.	
E.G.A.	

File 104 G

Subject: Nahiku - Tokud Rivers Area

1957 Season (Ref. Map 104G)

Th: Exploration for PA 1957 Season

, CGS, and covered gen-

erally to
longitude
Jan 25 1957

na River and from
southern half of the

area, horse parties were used in the area west of Dease Lake in the northern half.

Fred Roots advises the preliminary report and map of the area has been proof-read and is now in the hands of the printers. If there is any delay in the production of the maps - which are on a scale of 4 miles to 1 inch - he will endeavour to forward the first available copies to individuals that have expressed an interest in the area.

Under the general direction of Roots, Jack Souther mapped the area south of Telegraph Creek, the general area where prospecting possibilities might be considered in 1957. The mapping is incomplete around Sphaler Creek (map 104G) latitude 57-05° and around Yeheniko Lake (map 104G) latitude 57-35° and in several similar small areas, and the plan for 1957 is that Souther will complete that work in 1957.

The prospecting possibilities of the Mess Creek area, longitude 131° (map 104G) were discussed and Souther reported:

- (1) He examined the narrow vein of quartz containing chalcopyrite on the south end of the mountain immediately west of Mess Creek Lake. He could find no extension to the showing and no parallel structure confirming the opinion of the undersigned, who visited the location in 1954, that this showing is not interesting.
- (2) Souther saw a copper mineralized outcrop at the north end of the plateau lake at elevation 4,500 feet on the east side of the head of Mess Creek at latitude 57-15°.
- (3) He observed an outcrop of ultrabasic rock on the south end of the

~~PM~~

3/14

1049

1049

Operation Stikine - CGS - 1956

A	N
<input checked="" type="checkbox"/> W.S.H.	<input checked="" type="checkbox"/>
<input checked="" type="checkbox"/> E.C.J.	
<input type="checkbox"/> E.C.J.	
<input type="checkbox"/> R.W.B.	
<input checked="" type="checkbox"/> J.K.	
<input type="checkbox"/> E.L.D.	
<input type="checkbox"/> E.G.A.	

Subject: Exploration Possibilities for Prospectors Airways 1957 Season (Ref. Map 104G)

This operation was under the direction of Fred Roots, CGS, and covered generally the area between the Iskut River north to the Nakina River and from longitude 129° to 131°. Two helicopters were used in the southern half of the area, horse parties were used in the area west of Dease Lake in the northern half.

Fred Roots advises the preliminary report and map of the area has been proof-read and is now in the hands of the printers. If there is any delay in the production of the maps - which are on a scale of 4 miles to 1 inch - he will endeavour to forward the first available copies to individuals that have expressed an interest in the area.

Under the general direction of Roots, Jack Souther mapped the area south of Telegraph Creek, the general area where prospecting possibilities might be considered in 1957. The mapping is incomplete around Sphaler Creek (map 104G) latitude 57-05° and around Yeheniko Lake (map 104G) latitude 57-35° and in several similar small areas, and the plan for 1957 is that Souther will complete that work in 1957.

The prospecting possibilities of the Mess Creek area, longitude 131° (map 104G) were discussed and Souther reported:

- (1) He examined the narrow vein of quartz containing chalcopyrite on the south end of the mountain immediately west of Mess Creek Lake. He could find no extension to the showing and no parallel structure confirming the opinion of the undersigned, who visited the location in 1954, that this showing is not interesting.
- (2) Souther saw a copper mineralized outcrop at the north end of the plateau lake at elevation 4,500 feet on the east side of the head of Mess Creek at latitude 57-15°.
- (3) He observed an outcrop of ultrabasic rock on the south end of the

1049-1049

timberline, both sides of the valley of Mess Creek and Sphaler Creek and as much examination of the country west of Mess Creek as the time will permit.

A	N
W.S.H.	
E.O.C.	
R.D.S.	
E.C.I.	
R.W.B.	
J.K.	
E.L.D.	
E.G.A.	

Organization

Two prospecting teams, 1 supervisor, 1 helicopter and pilot. Field base Mess Creek Lake. Supply Base - either Telegraph Creek or Wrangell, Alaska. July 15th to August 15th, 1957.


Preliminary Estimate of Cost

Including helicopter rental, wages, supplies, \$5,000.00. Large block staking if warranted, is not included in the estimate.


RM/ss
2 c.c.

Roderick Macrae
R. Macrae.

Sands okay. Probably love to watch area before July due to activity there now
BOC

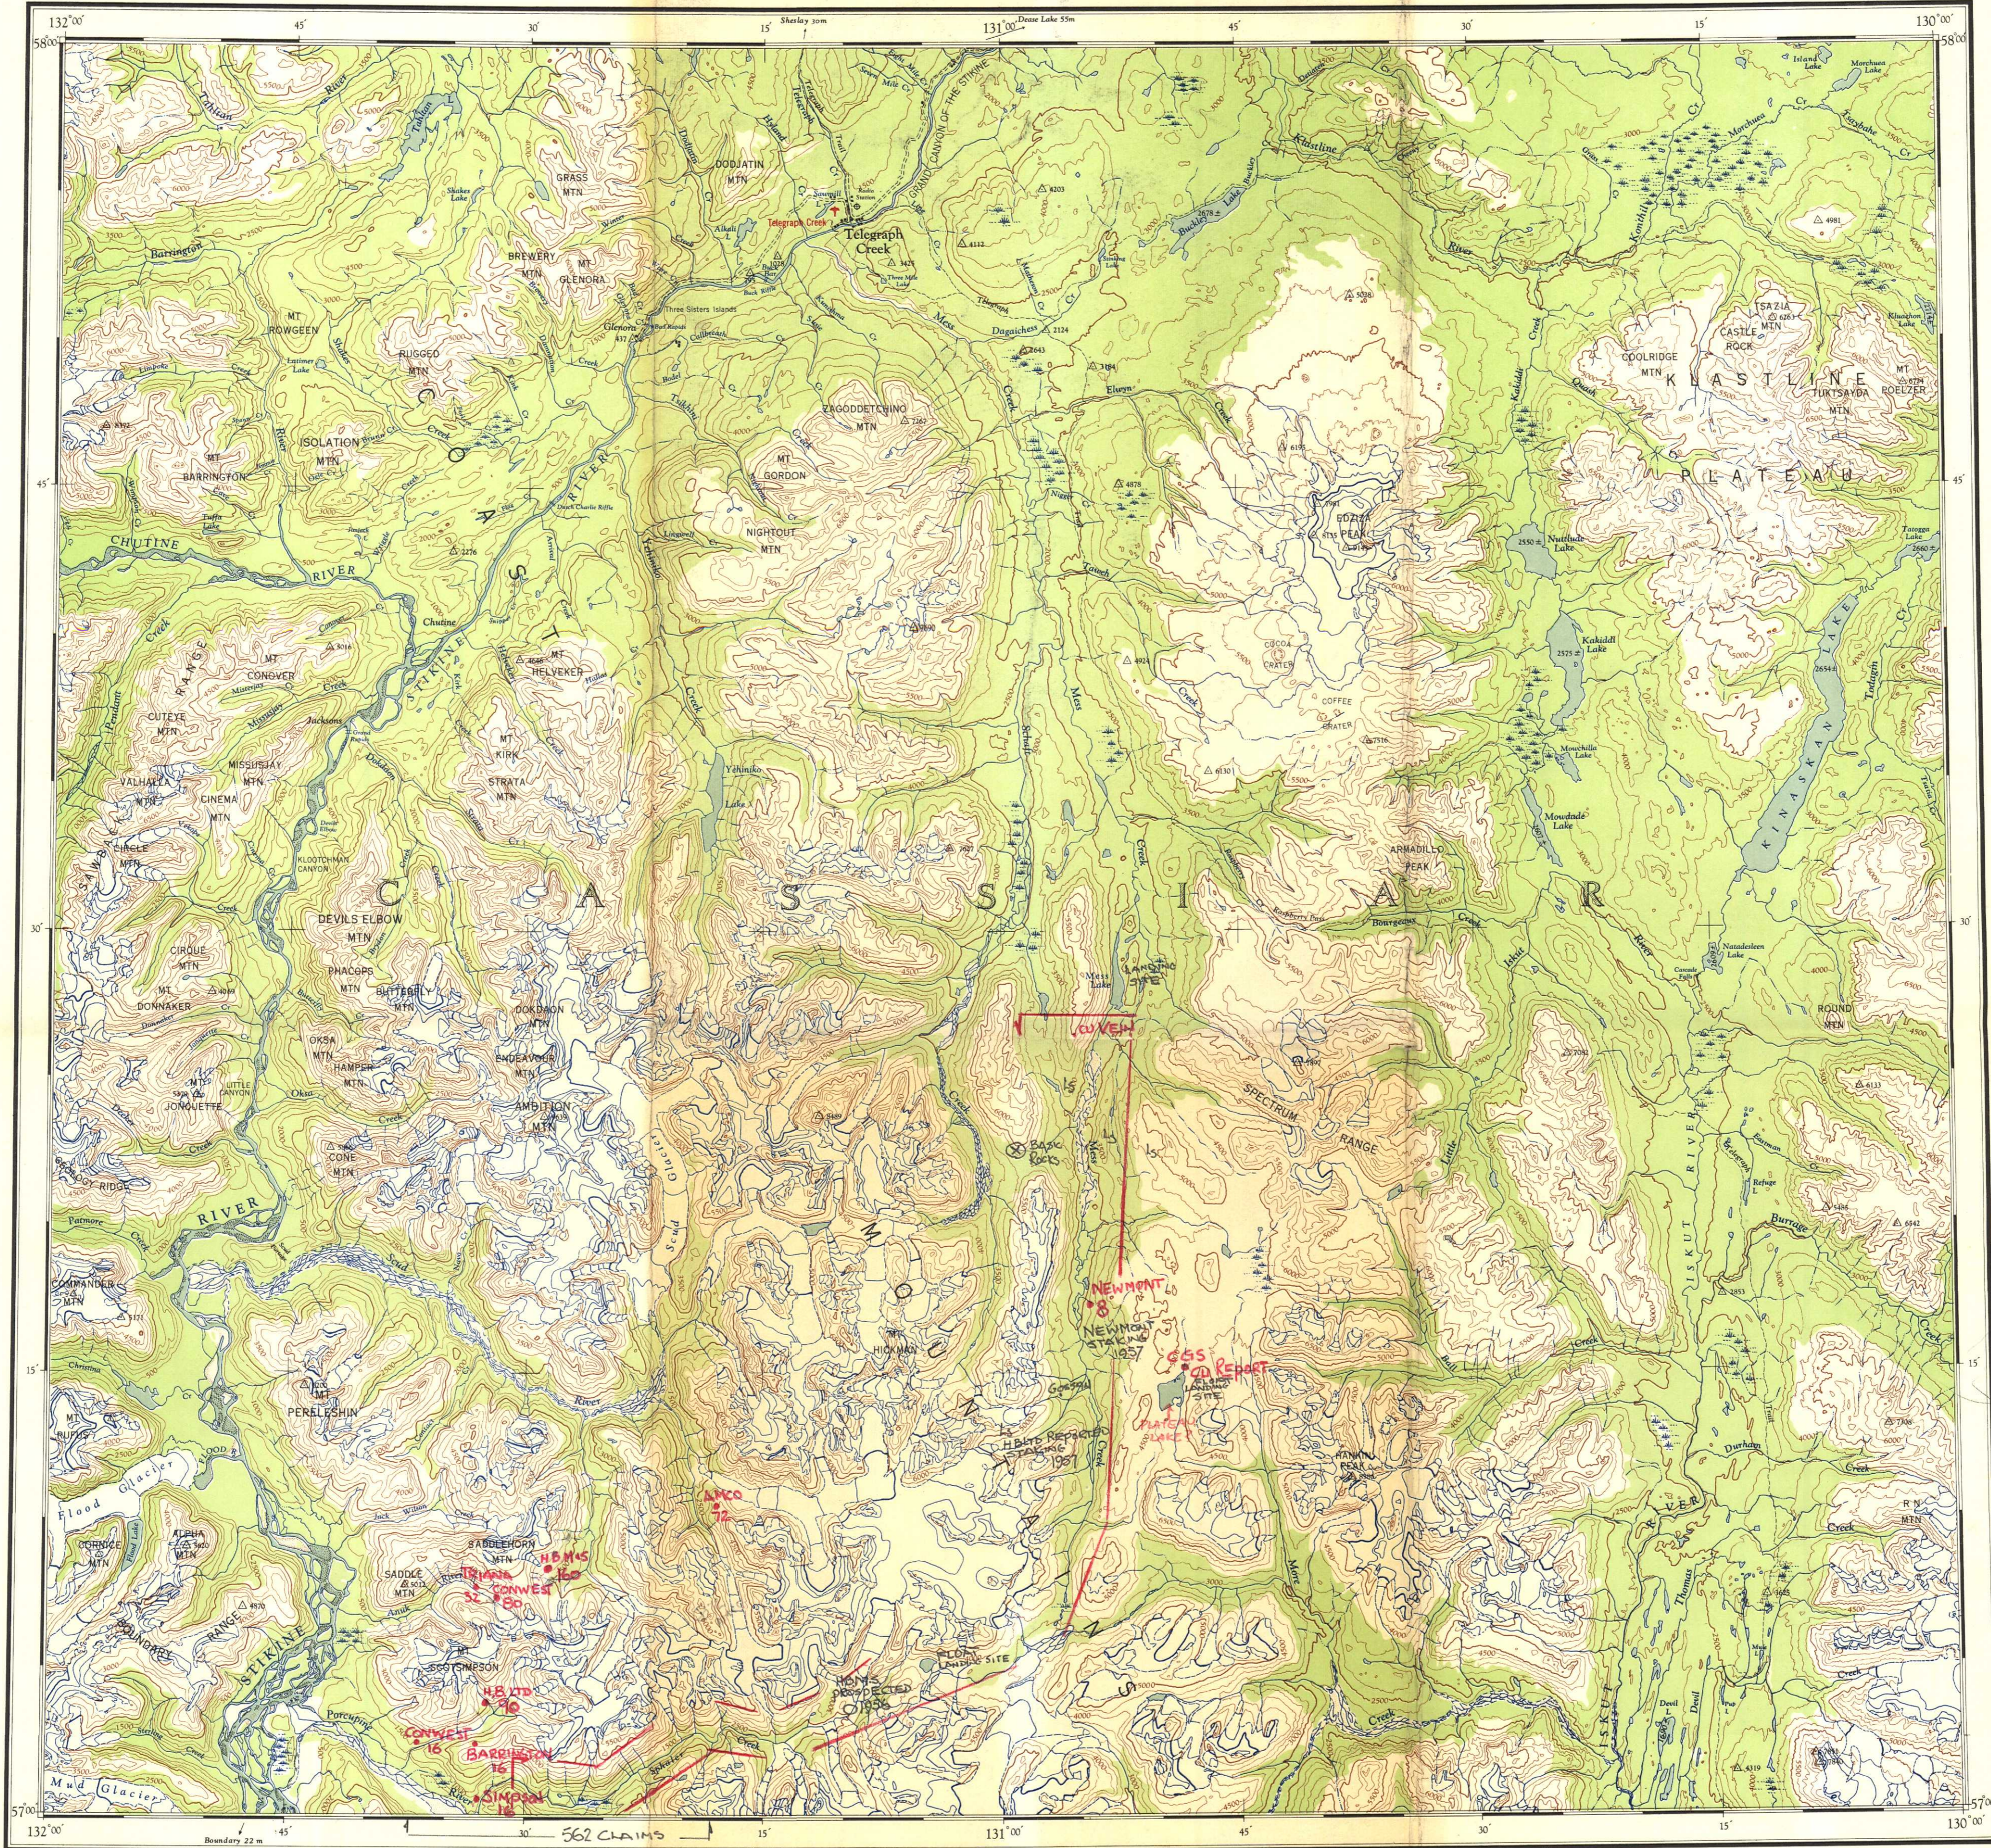



THE DECLINATION OF THE COMPASS NEEDLE, 1954

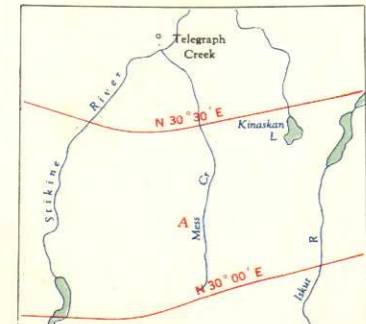

The declination of the compass needle at any place along a red line is the declination given on that red line. At other places the declination is known from those given on the neighbouring red lines, those at the place marked A, the declination is between N. 35° 50' E. and N. 35° 10' E. The nearby declinations of the compass needle are decreasing 4 minutes annually.

Surveyed, compiled, drawn and printed by the ARMY SURVEY ESTABLISHMENT R.C.E., 1950-54. Aerial photography by the R.C.A.F., 1949. Universal Transverse Mercator Projection.

REFERENCE table with symbols for Road, Hand Surface, All Weather, Lower Surface, All Weather, Cart Track, Trail, Railway, Multiple Track, Single Track, Boundary, International, Presence or Absence of Snow, Cause or Ditch, Reservoirs, Indian, Military, etc.

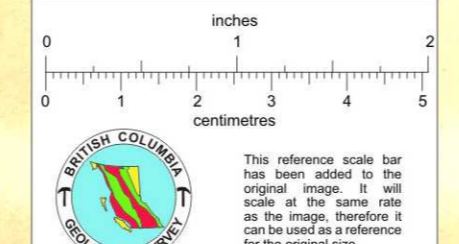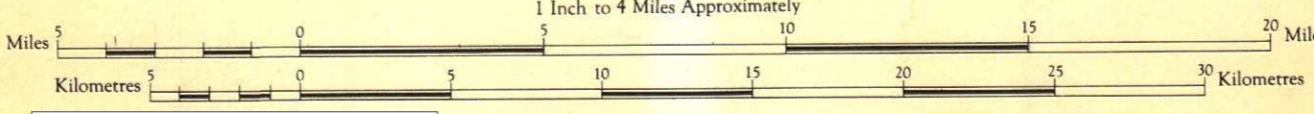


TELEGRAPH CREEK

BRITISH COLUMBIA Scale 1: 250,000 1 Inch to 4 Miles Approximately

Copies may be obtained from The Map Distribution Office, Dept. of Mines and Technical Surveys, Ottawa, at 25 cents each.

Contour Interval 500 Feet All Elevations in Feet above Mean Sea Level. North American Datum 1927 Preliminary 1953

REFERENCE table with symbols for Horizontal Control Point, Contours, Elevation, Depression, Approximate, Glacier or Snowfield, Stream, Icebergs, Dam, Falls, Airfield, on Land, Water, Landing Ground, Anchorage, Power Transmission Line, Spot Elevation, Forest, Swamp or Marsh, Ferry, Lighthouse, Mud, Sand.

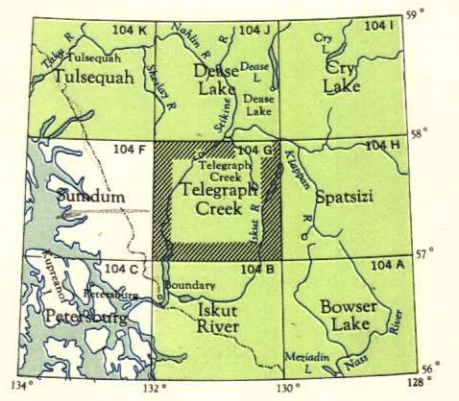

NOTE: On the above index the sheets published are shown shaded green.