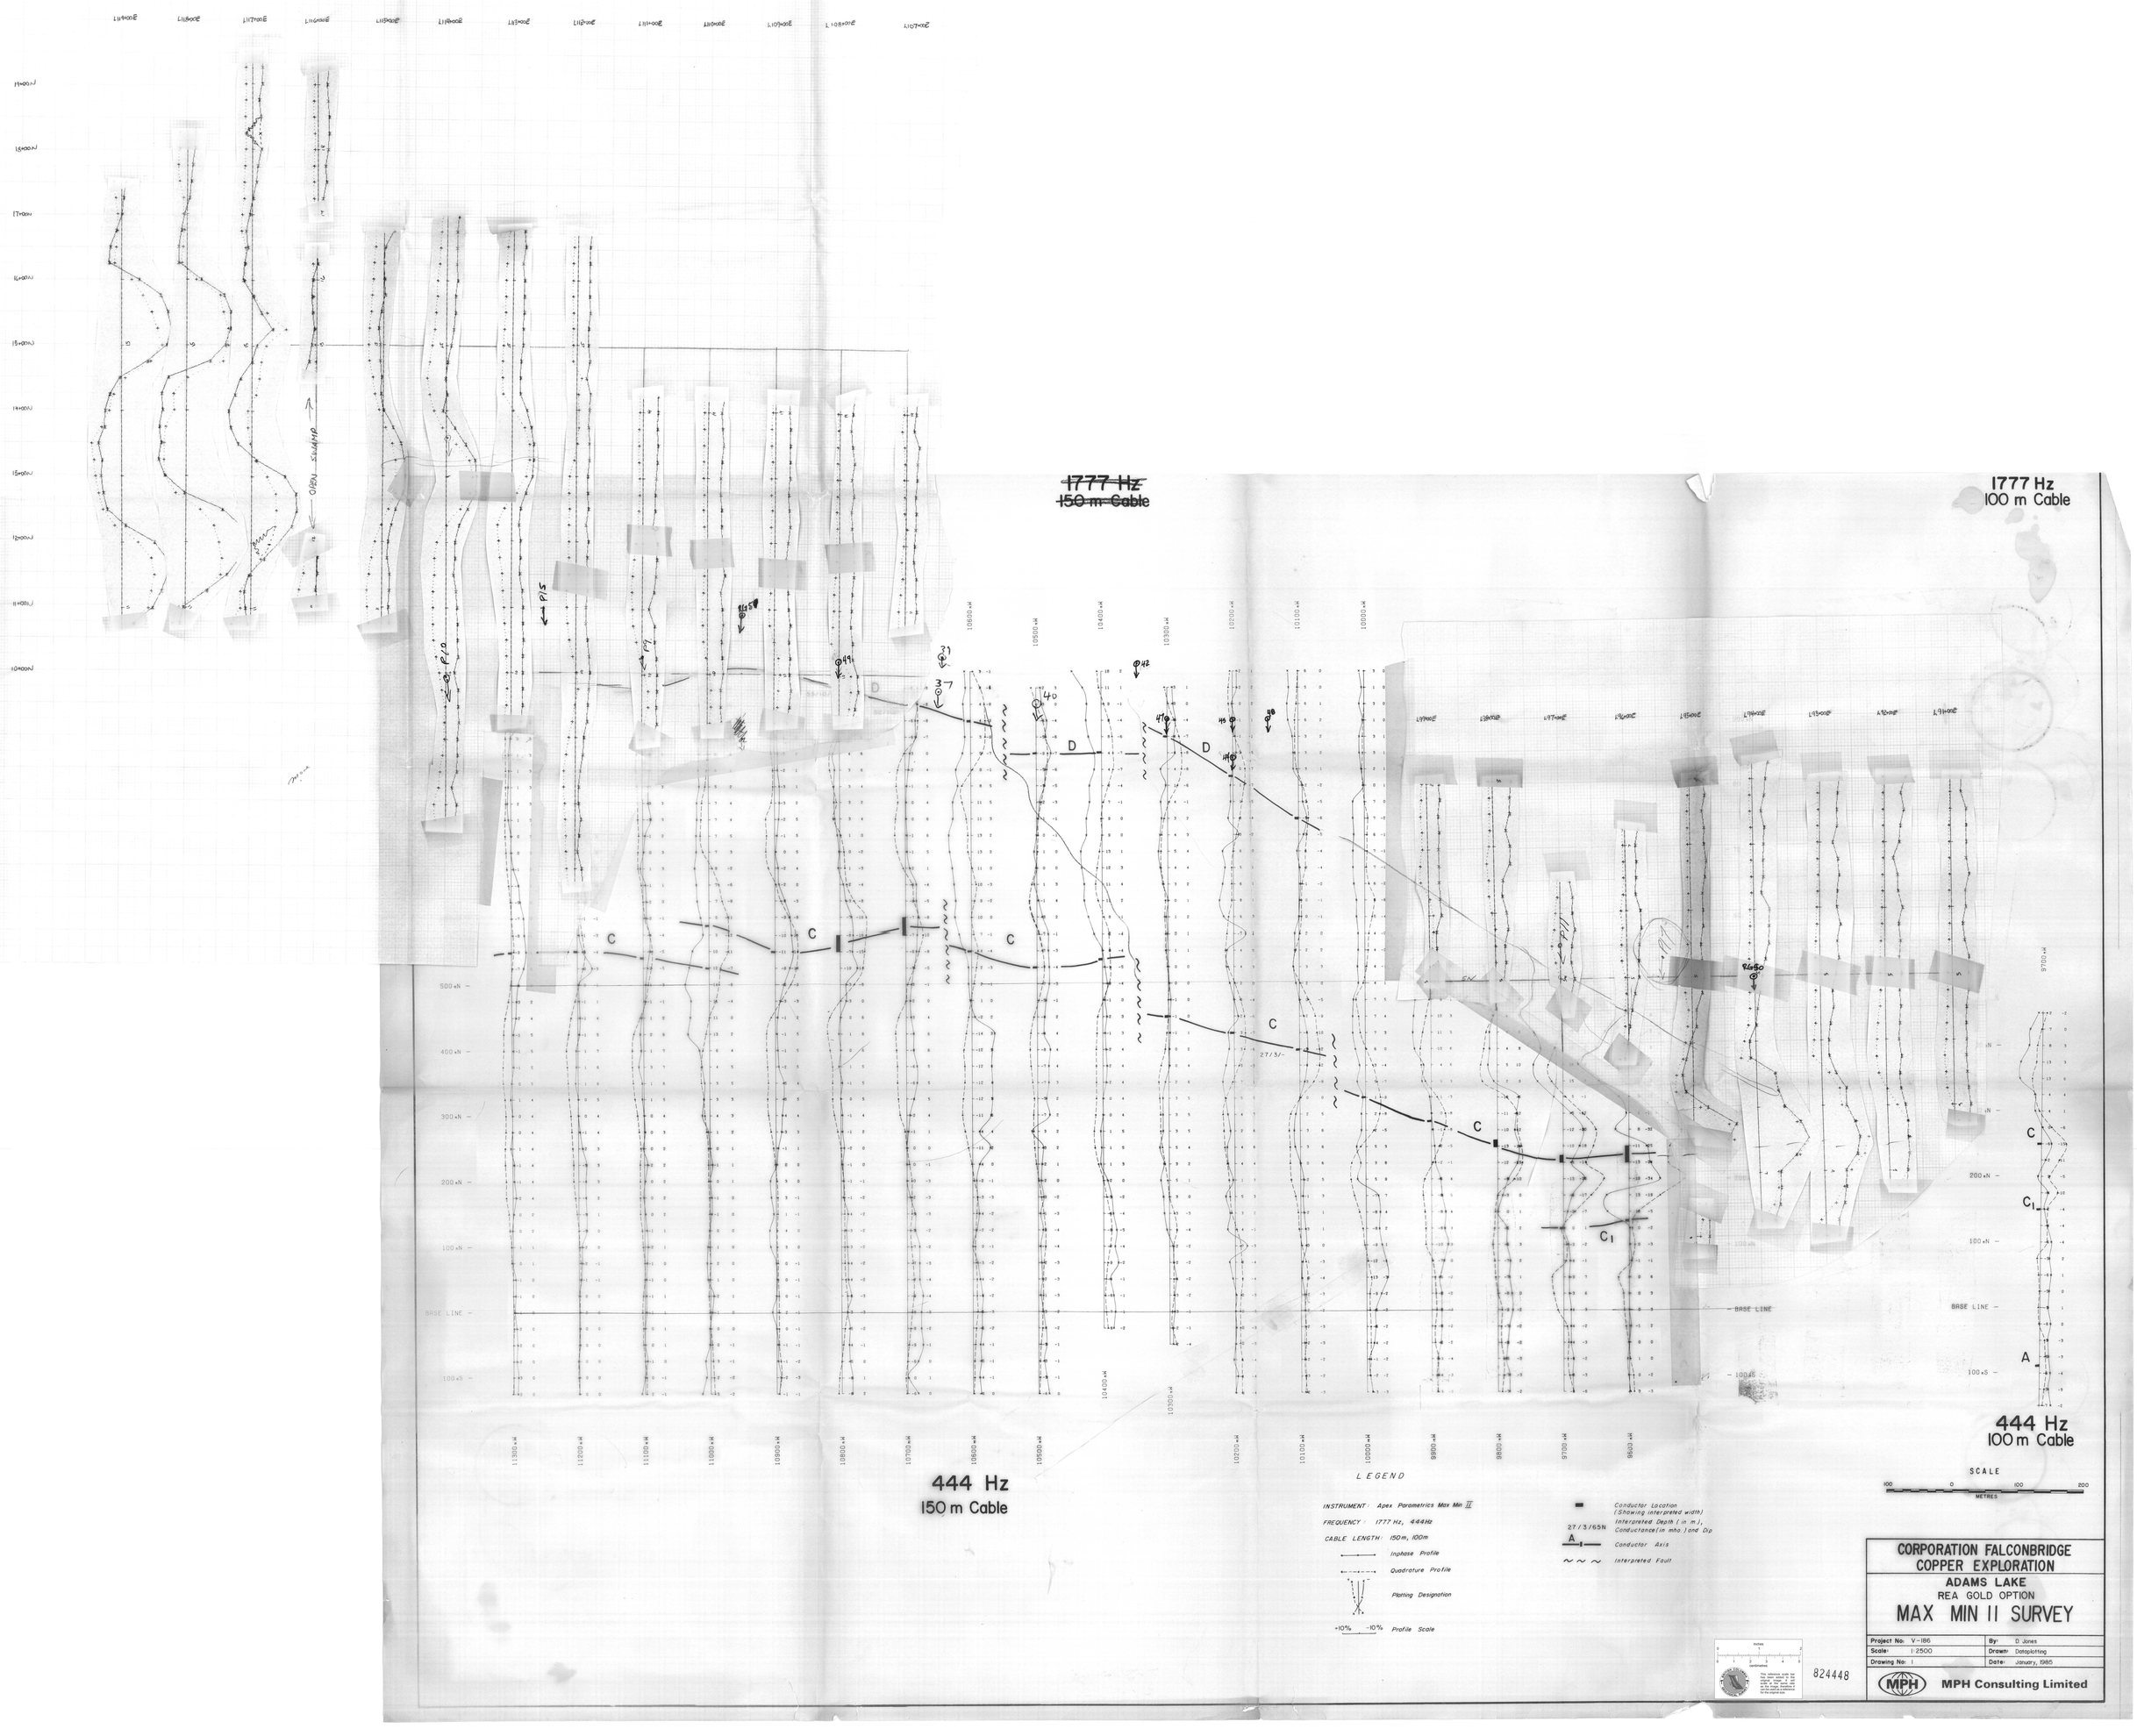
~~1777 Hz~~
~~150 m Cable~~
1777 Hz
100 m Cable
444 Hz
150 m Cable
444 Hz
100 m Cable
LEGEND
INSTRUMENT: Apex Parametrics Max Min II
FREQUENCY: 1777 Hz, 444Hz
CABLE LENGTH: 150m, 100m
Inphase Profile
Quadrature Profile
Plotting Designation
+10% -10% Profile Scale
Conductor Location (Showing interpreted width)
27/3/65N Interpreted Depth (in m), Conductance (in mho) and Dip
Conductor Axis
Interpreted Fault
SCALE
METRES
CORPORATION FALCONBRIDGE COPPER EXPLORATION
ADAMS LAKE
REA GOLD OPTION
MAX MIN II SURVEY
Project No: V-186
By: D Jones
Scale: 1:2500
Drawn: Dataplotting
Drawing No: 1
Date: January, 1985
MPH Consulting Limited
824448