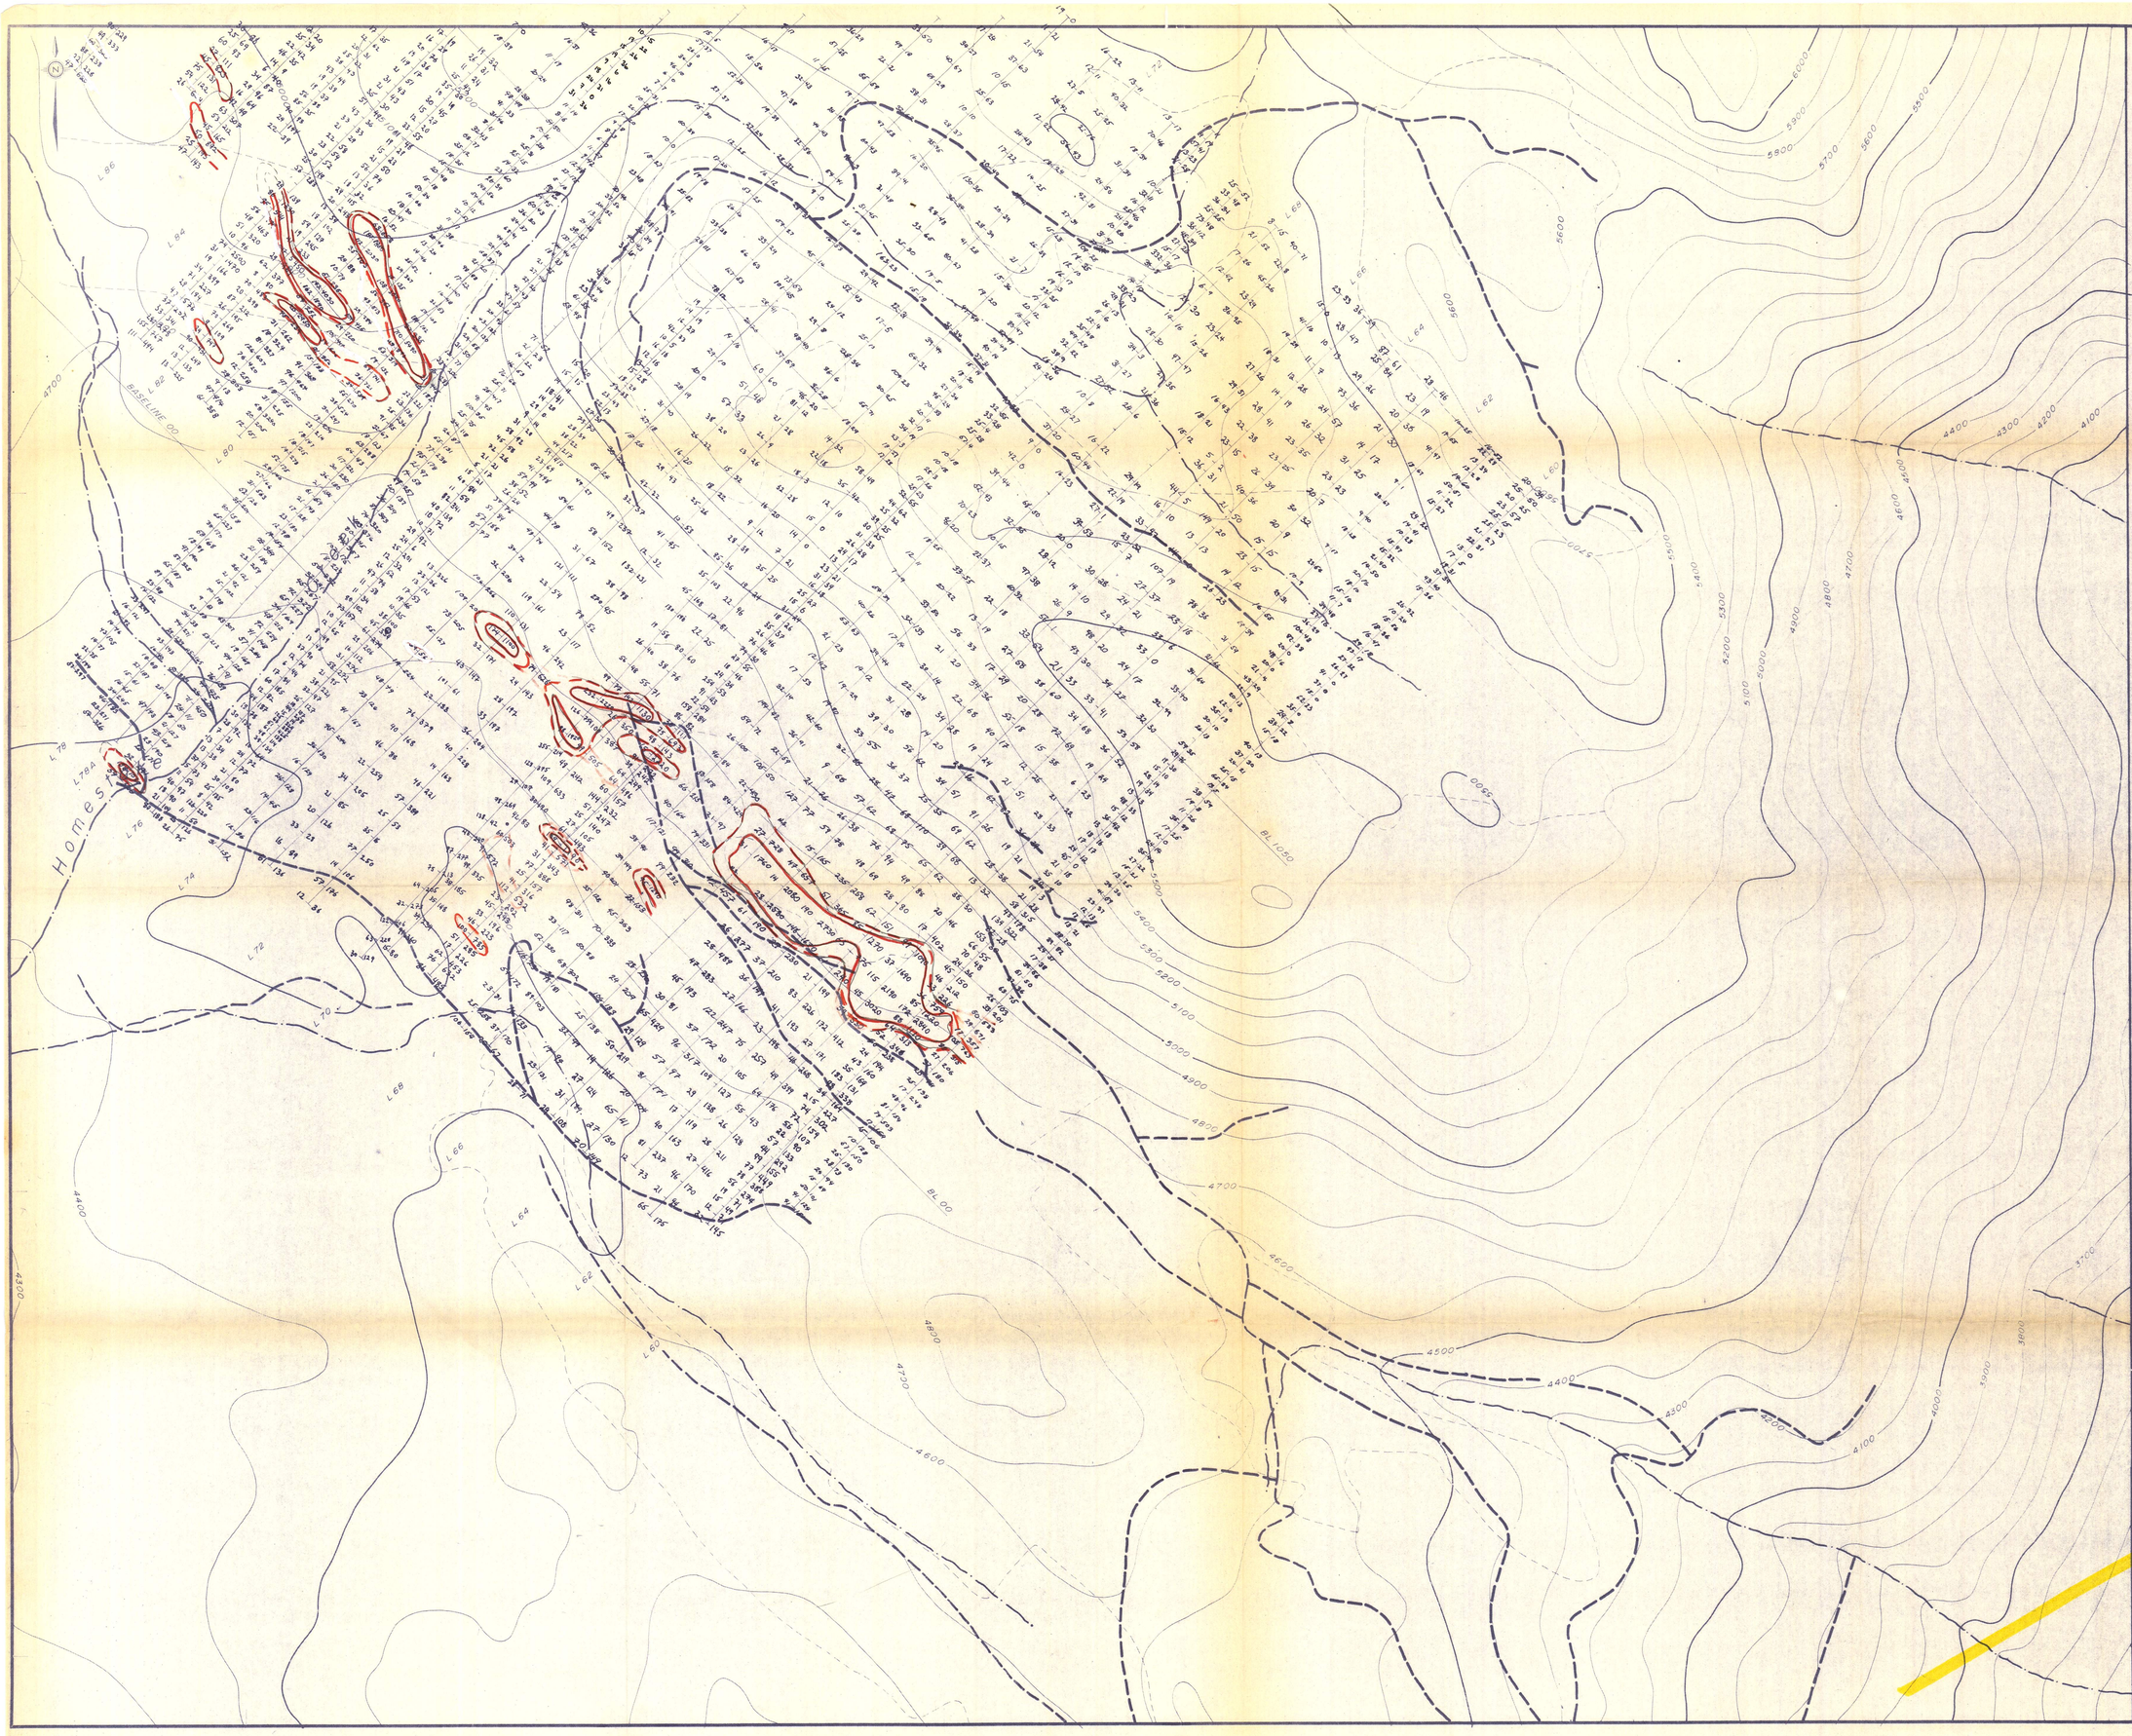


-LEGEND-

- LAKES
- RIVERS, CREEKS
- CONTOUR INTERVAL 100 FT.
- ROADS
- TREE CLEARING AREA

Zn >1000 ppm
Zn >636.8 ppm

corrected CMB 10/9/84 correct Aug 5th.

LOCATION MAP
SCALE 1:50,000

CORPORATION FALCONBRIDGE COPPER

# REA GOLD OPTION

~~SOIL~~ ~~LITHO~~GEOCHEMISTRY

Cu, Zn ppm

0 50 100 200 300 400 500 m
SCALE: 1:5000

DRAWN BY: IP/dg
DATE: MAY 1984 N.T.S. 82 M/4 W
FIG. NO.:

824620