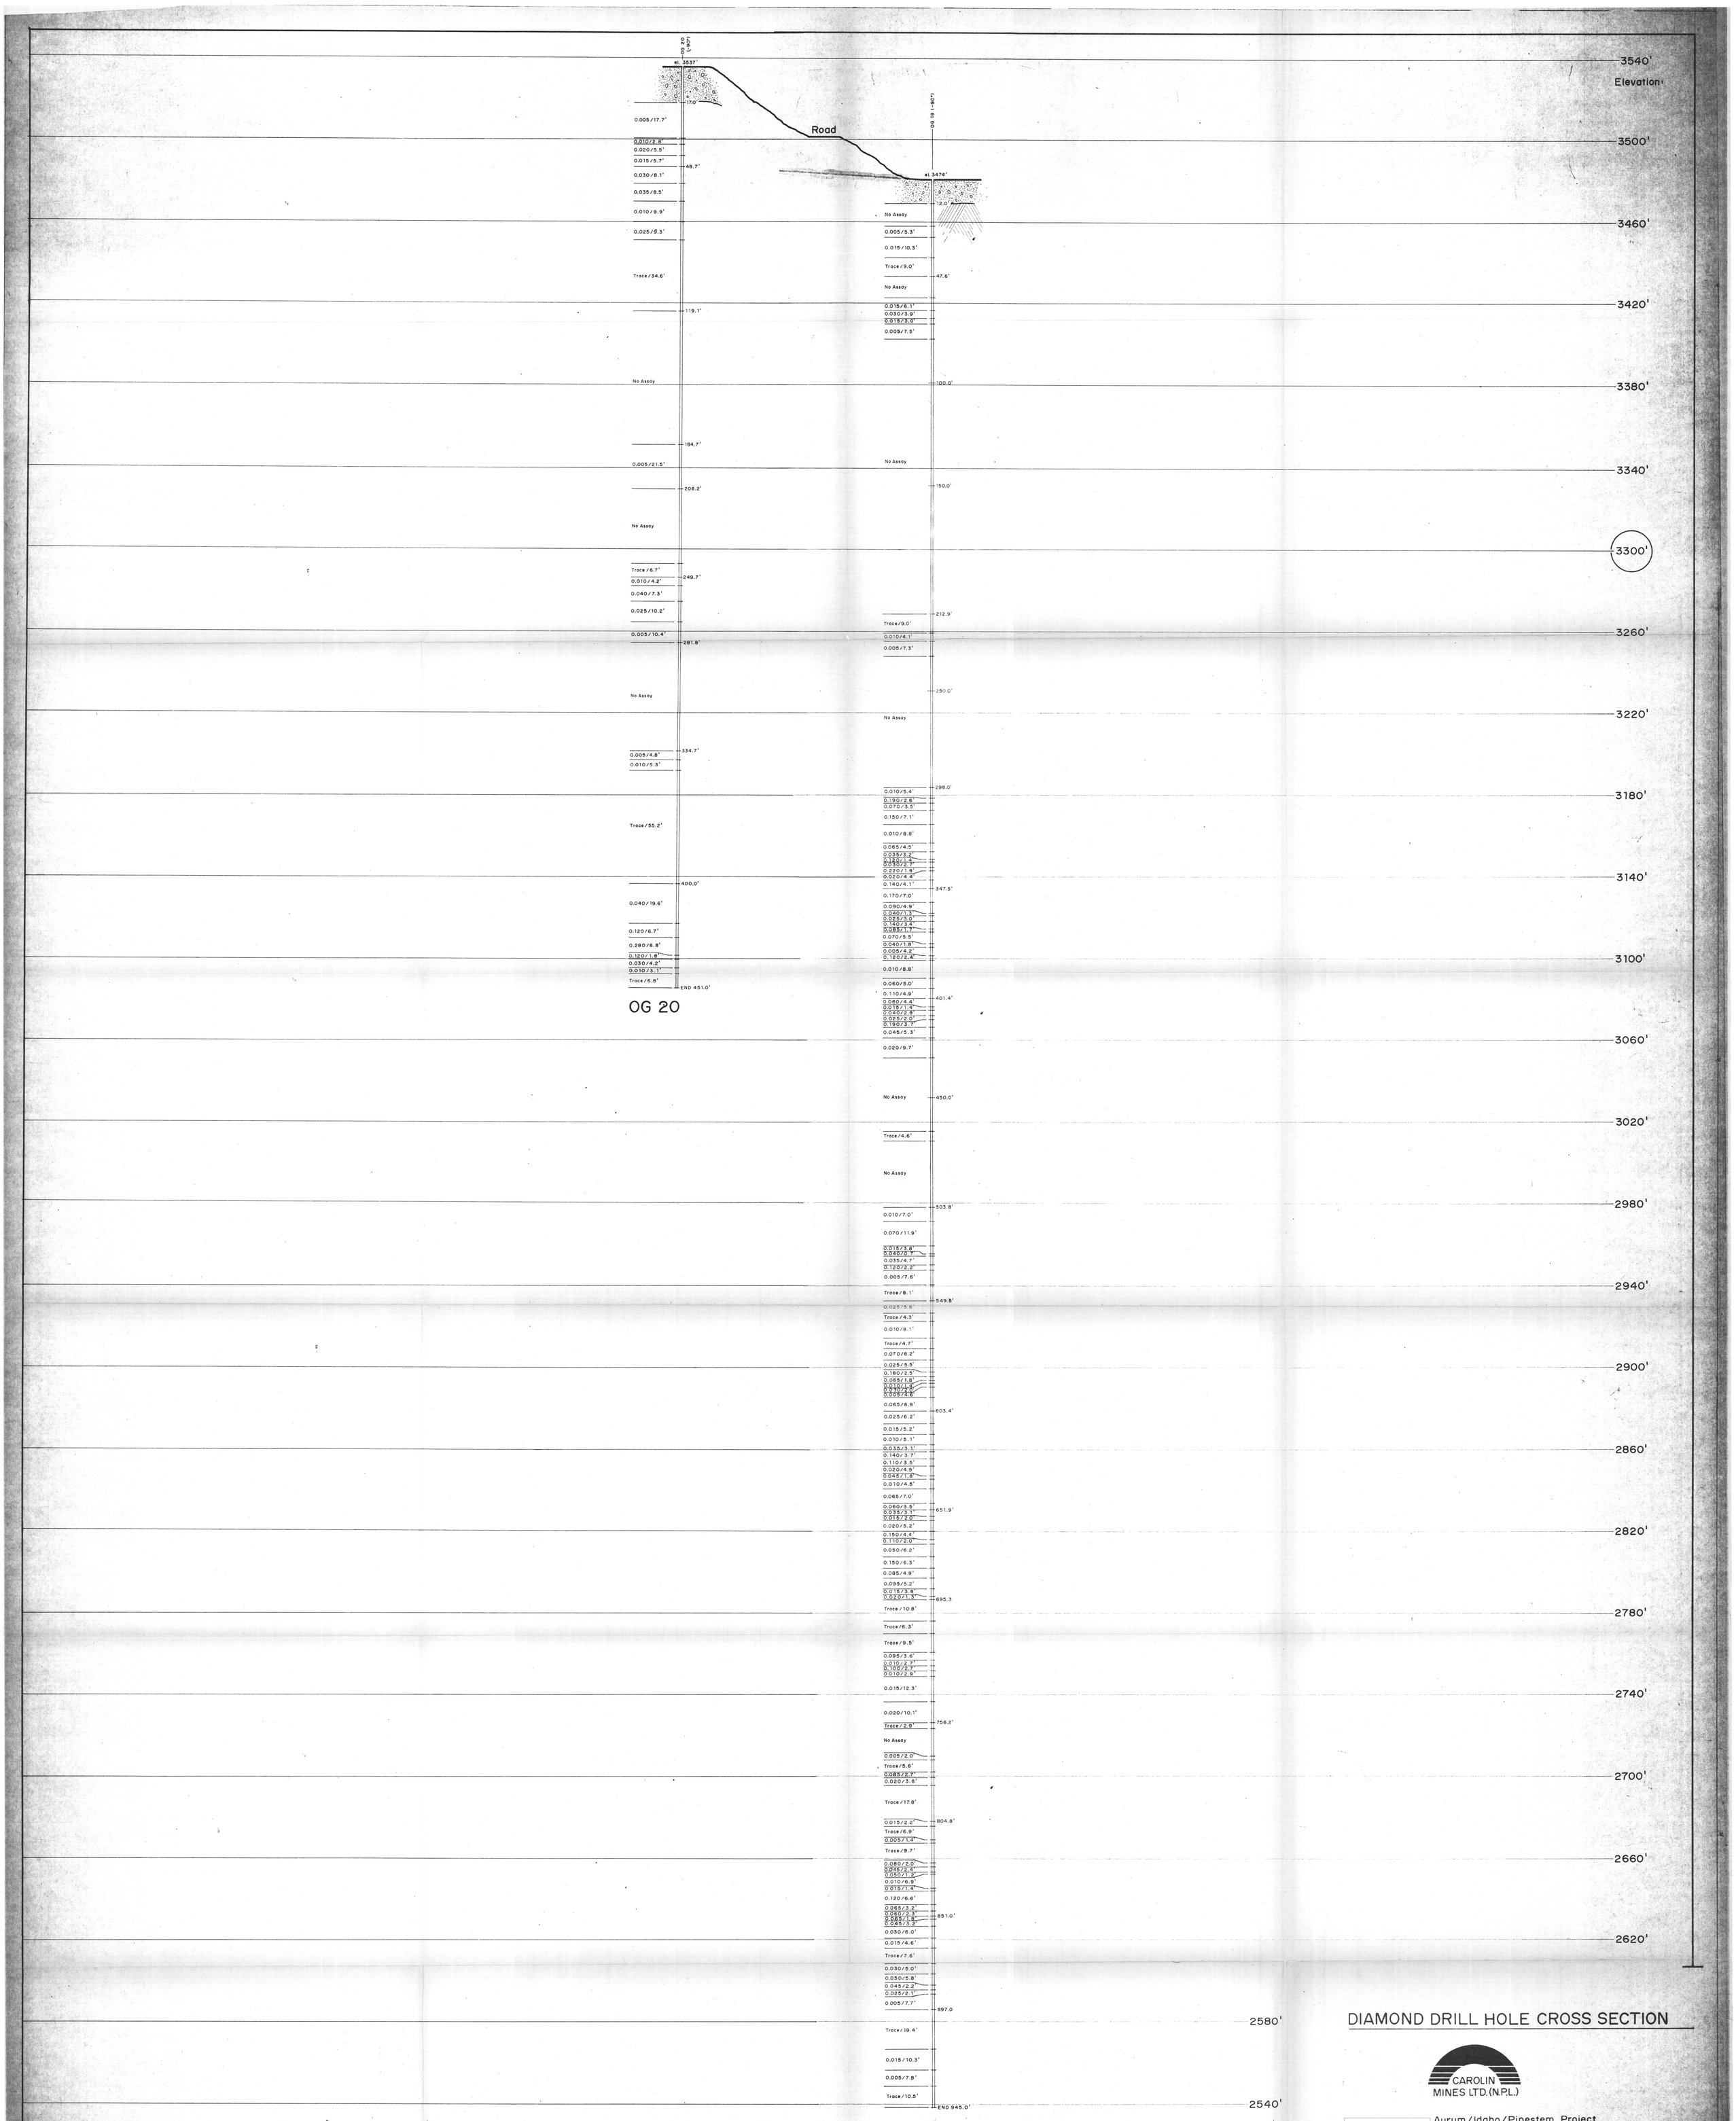

DIAMOND DRILL HOLE CROSS SECTION

CAROLIN MINES LTD.(N.P.L.)

Aurum/Idaho/Pipestem Project
Coquihalla River/Ladner Creek Area
New Westminster Mining Division, B.C.

SECTION Nº ~~19~~ 11, OG ~~19~~ & 20. FACE NORTH ~~WEST~~

SCALE: One inch equals twenty feet.
Vertical equals Horizontal. Drawn: B.A.C.
Checked:

0 20 40 60 feet

N.T.S. 92 H/11, east & west

Fig. 31

826788

Cochrane Consultants Limited
4252 Delta Street Delta, B.C.