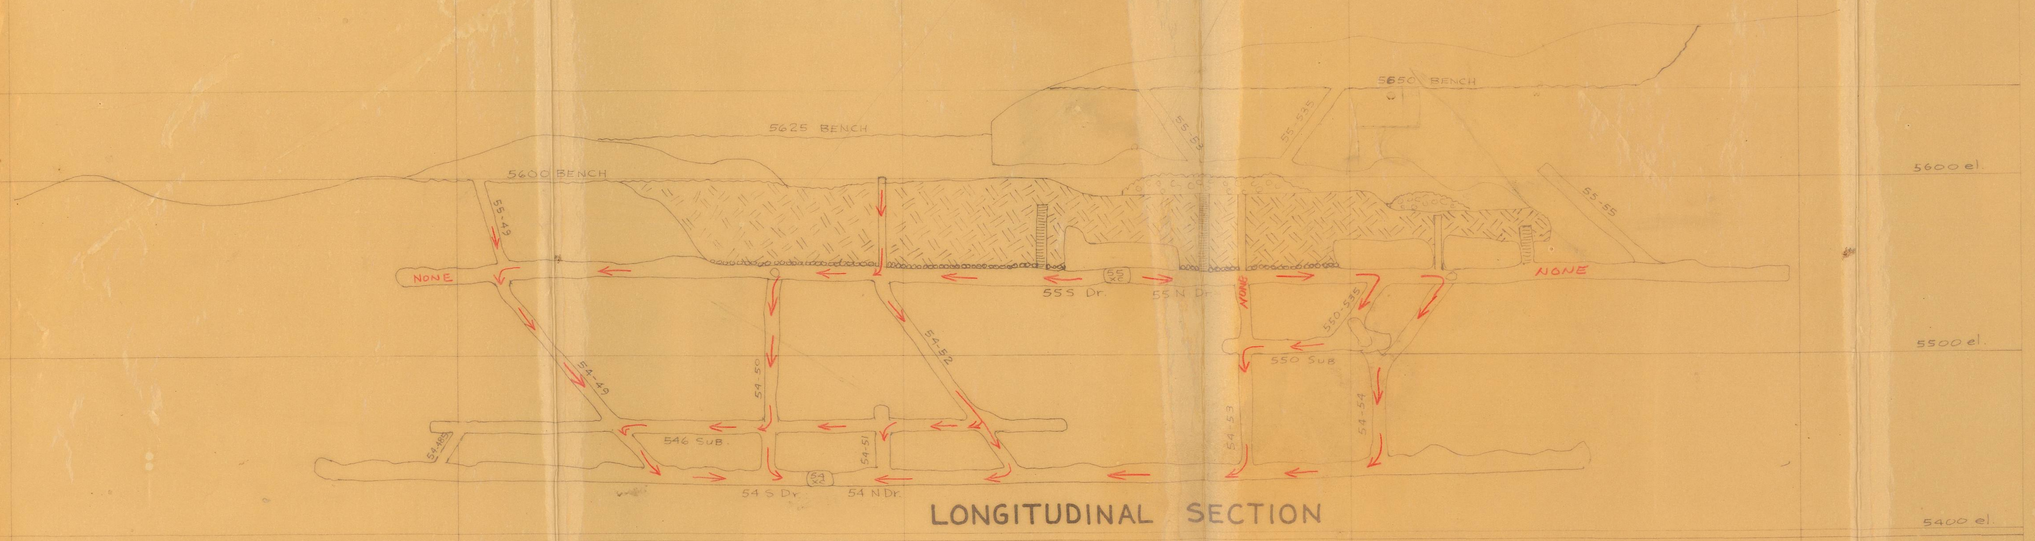

LONGITUDINAL SECTION

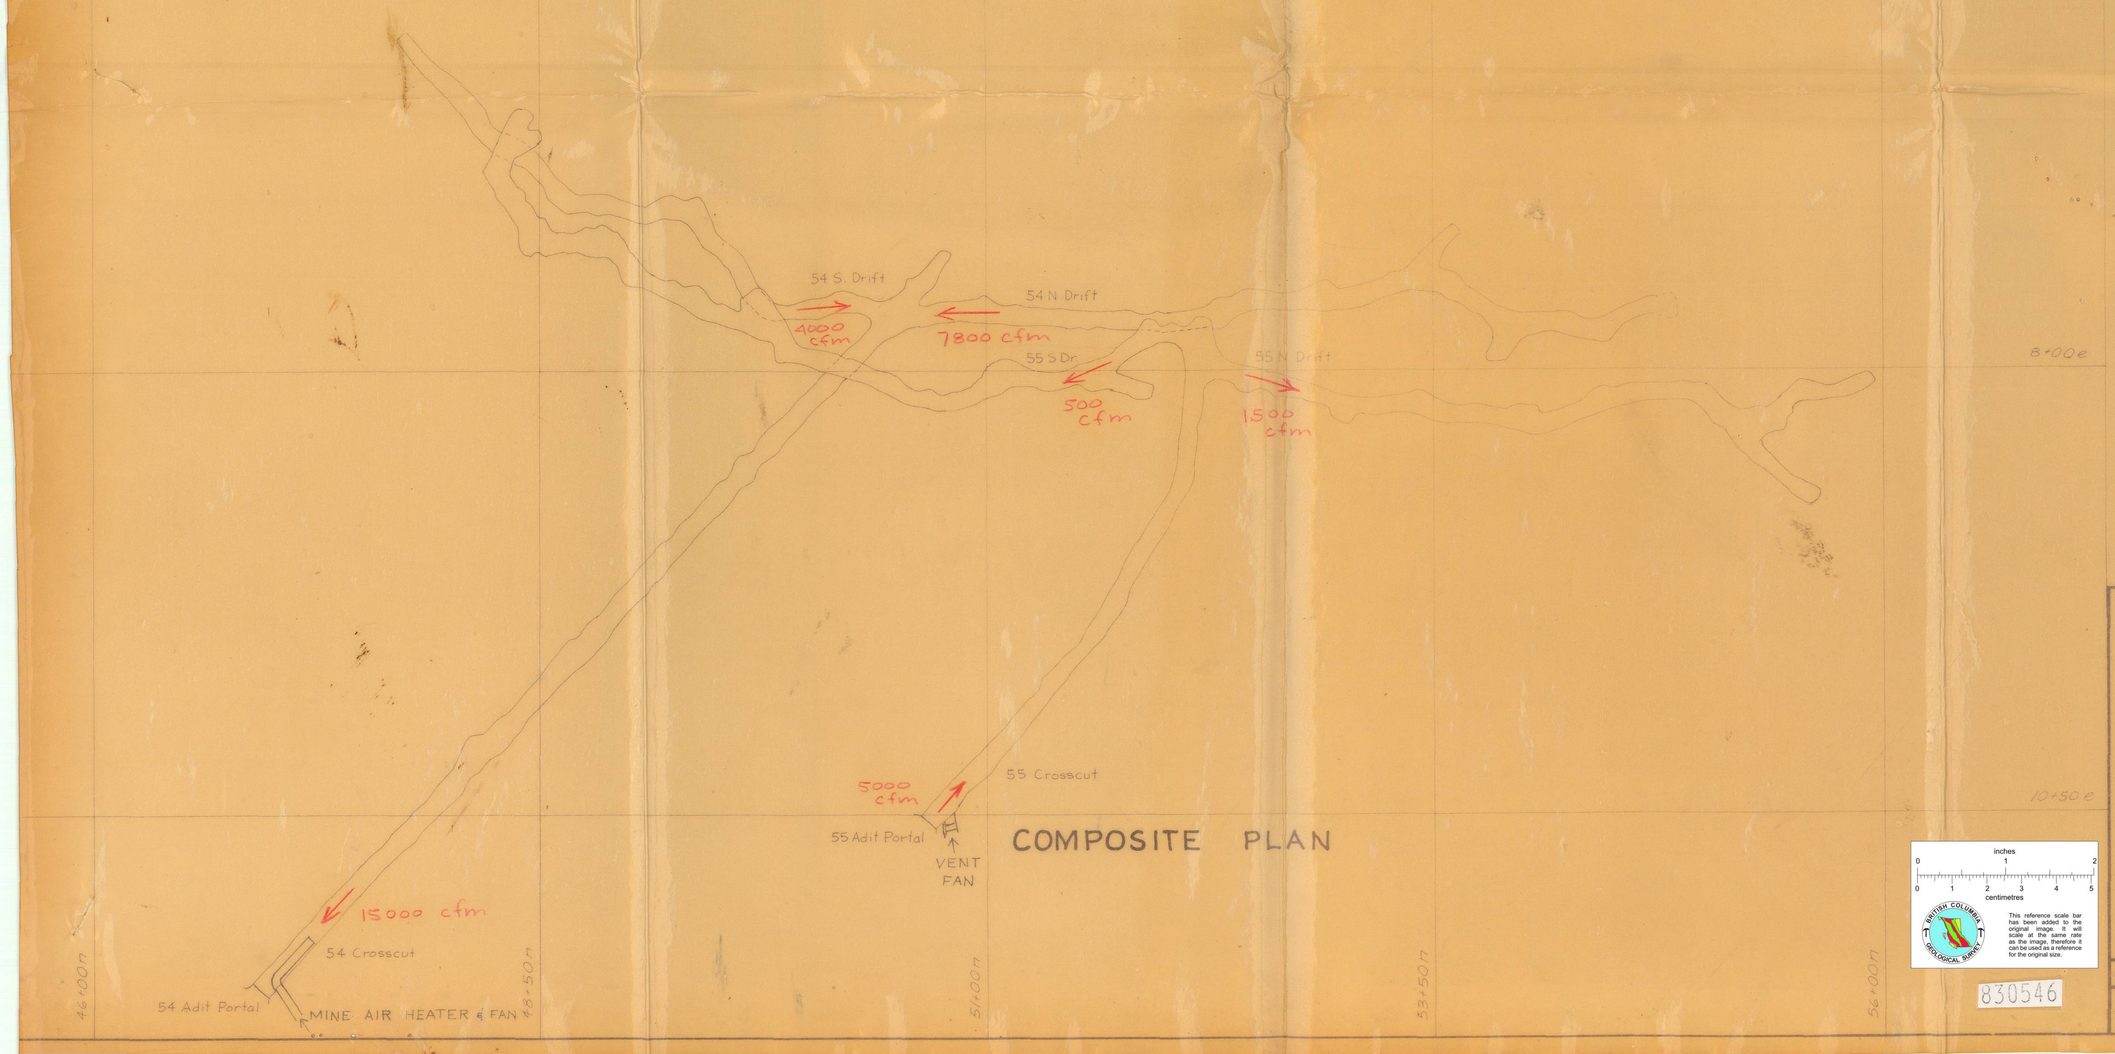

COMPOSITE PLAN

NATURAL VENTILATION
SHOWN IN RED
JUNE 22 1982
(FANS OFF)

inches
0 1 2
0 1 2 3 4 5
centimetres

BRITISH COLUMBIA GEOLOGICAL SURVEY

This reference scale bar has been added to the original image. It will scale at the same rate as the image, therefore it can be used as a reference for the original size.

830546

DU PONT EXPLORATION CANADA

BAKER MINE VENTILATION

SCALE 50 (0, 50, 100)
1 INCH = 50 FEET

MAPPED BY	REVISED	N.T.S. No.
DATE		ACCT No.
DRAWN BY		
DATE 24/06/82		DRWG. No.