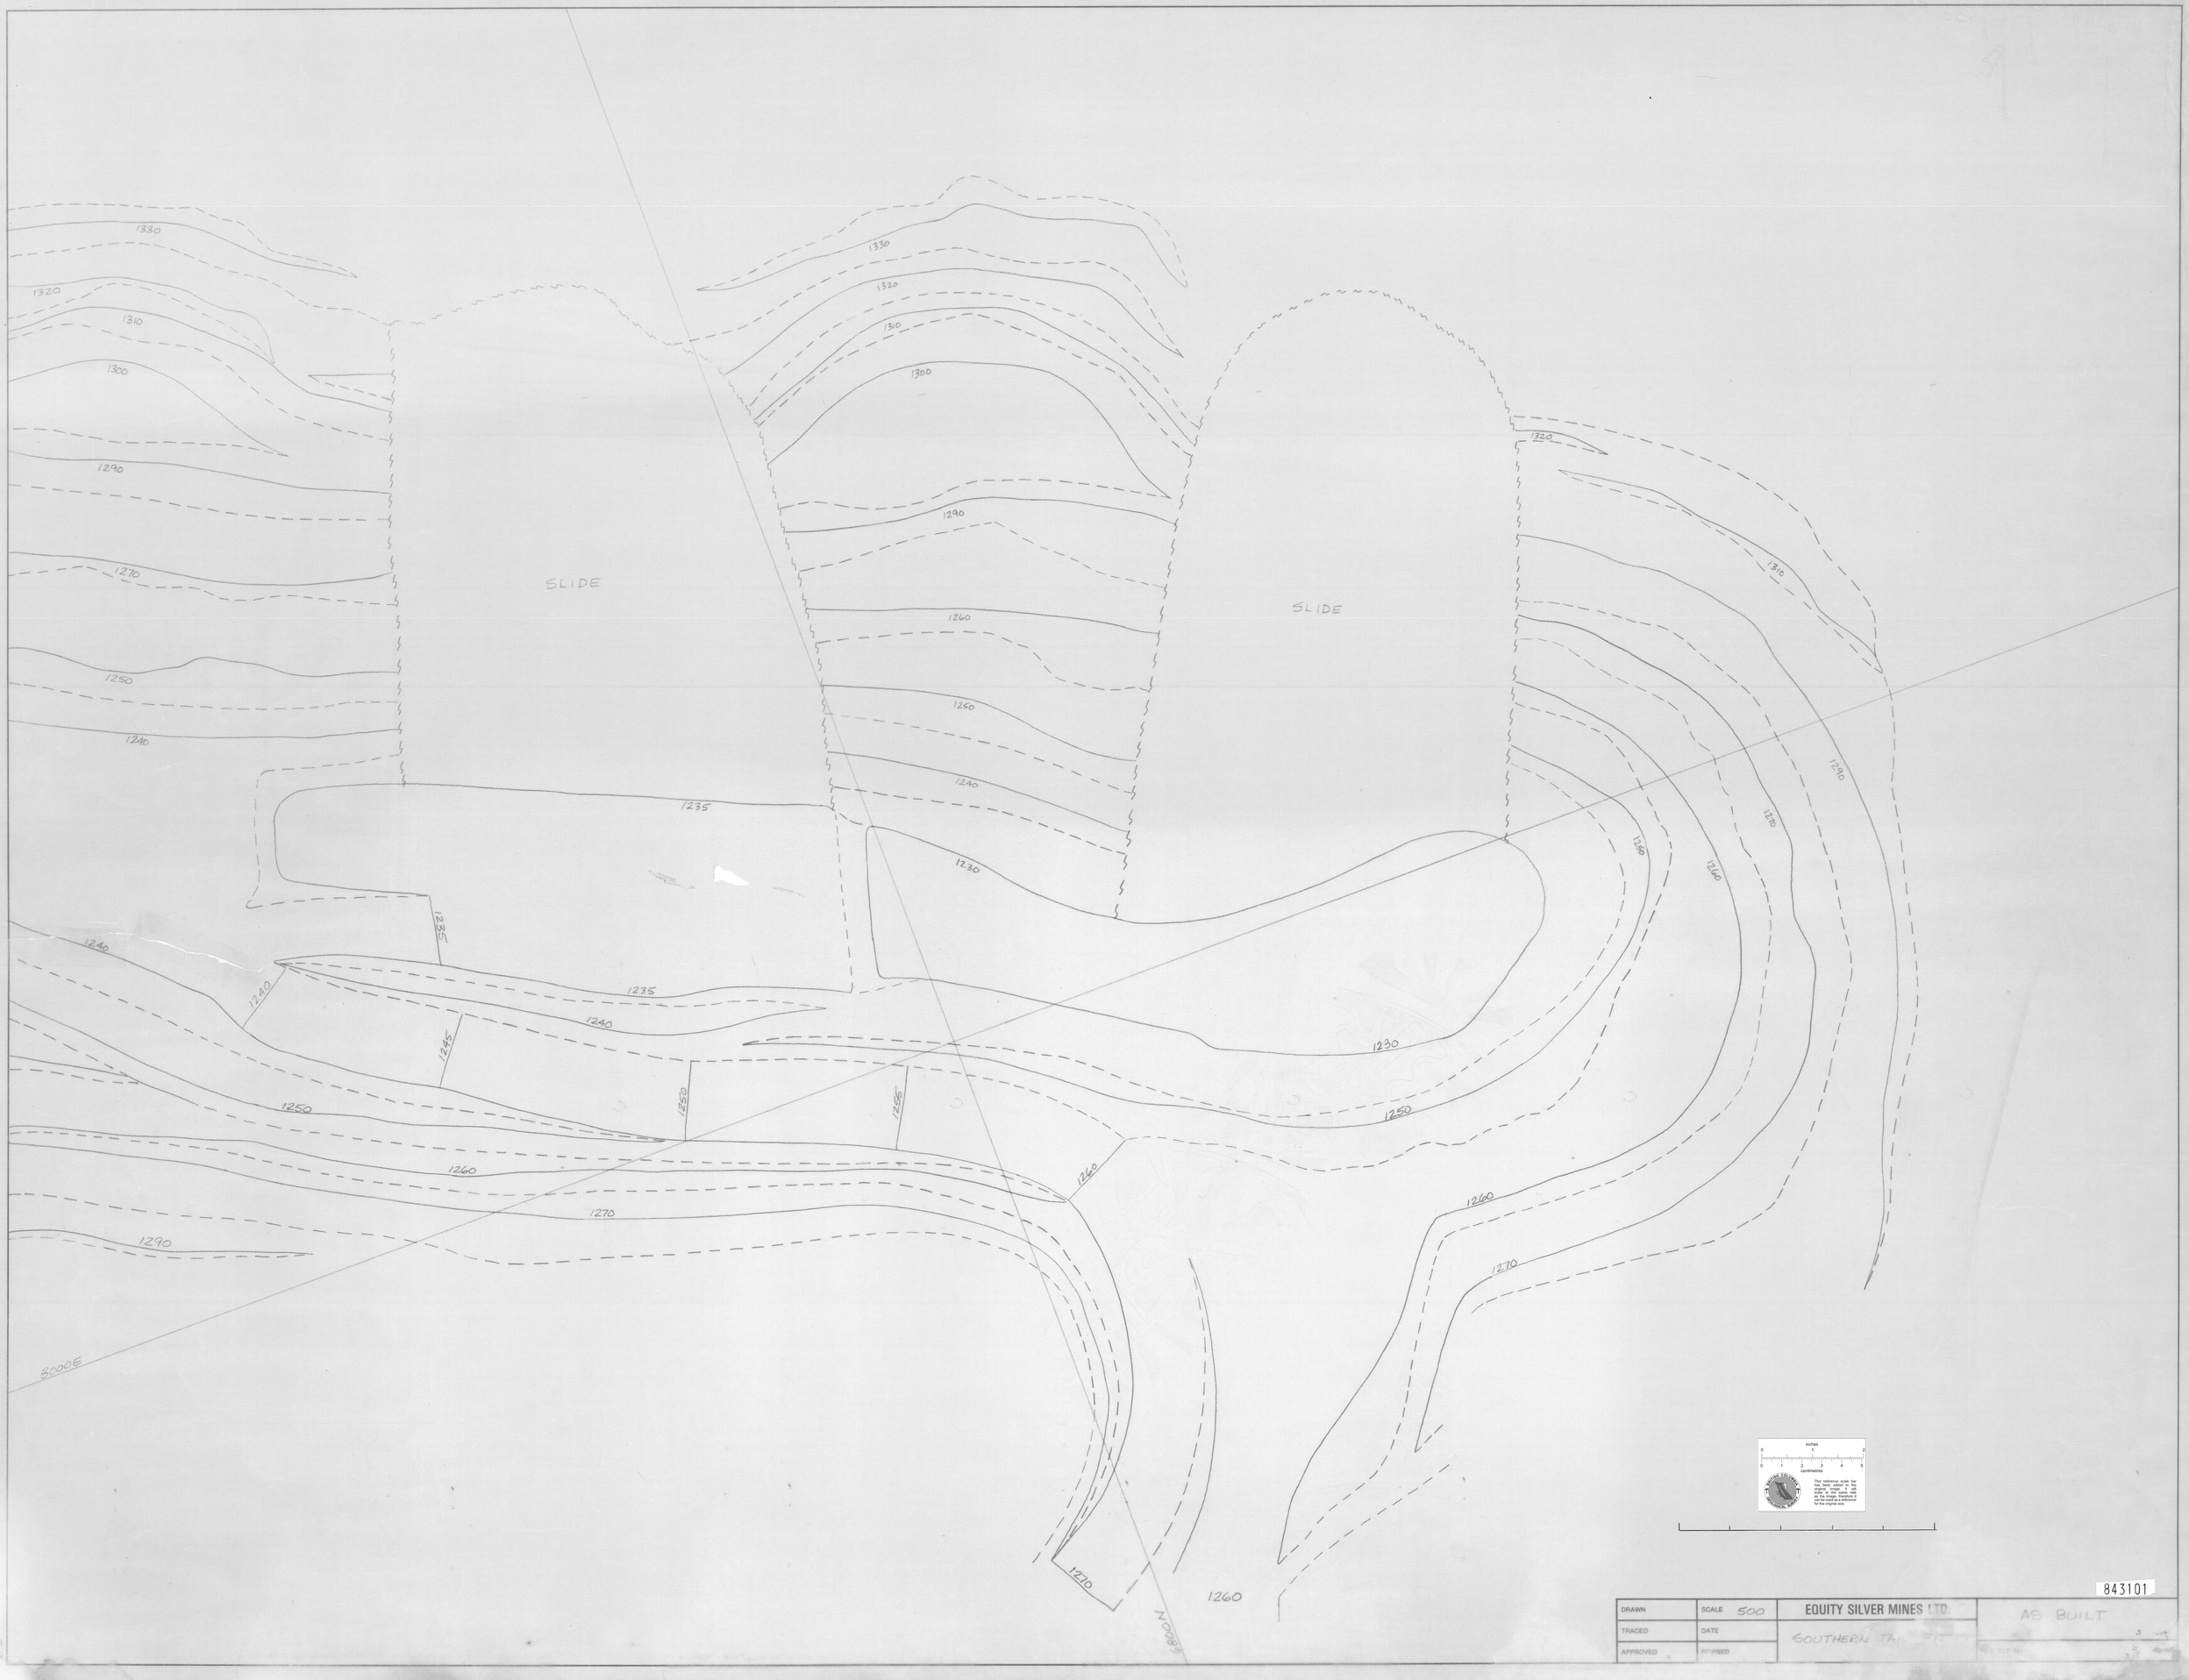

843101

DRAWN	SCALE 500	EQUITY SILVER MINES LTD	AS BUILT
TRACED	DATE	SOUTHERN TAIL PIT	
APPROVED	REVISED		DRAWING NO.