(1) Have all lines are numberd as such with base line numbers on as well

(2) Each stake and sample bag has the grid and Base line number on it

(3) All Lines with samples Taken marked in Red

To accompany a report entitled
"GEOLOGICAL & GEOCHEMICAL SURVEY
OF THE TWIN (1-3) CLAIMS, KAMLOOPS M.D., B.C.",
dated September 28, 1981, by:

S. CROFT

T. SADLIER-BROWN

B. FAIRBANK

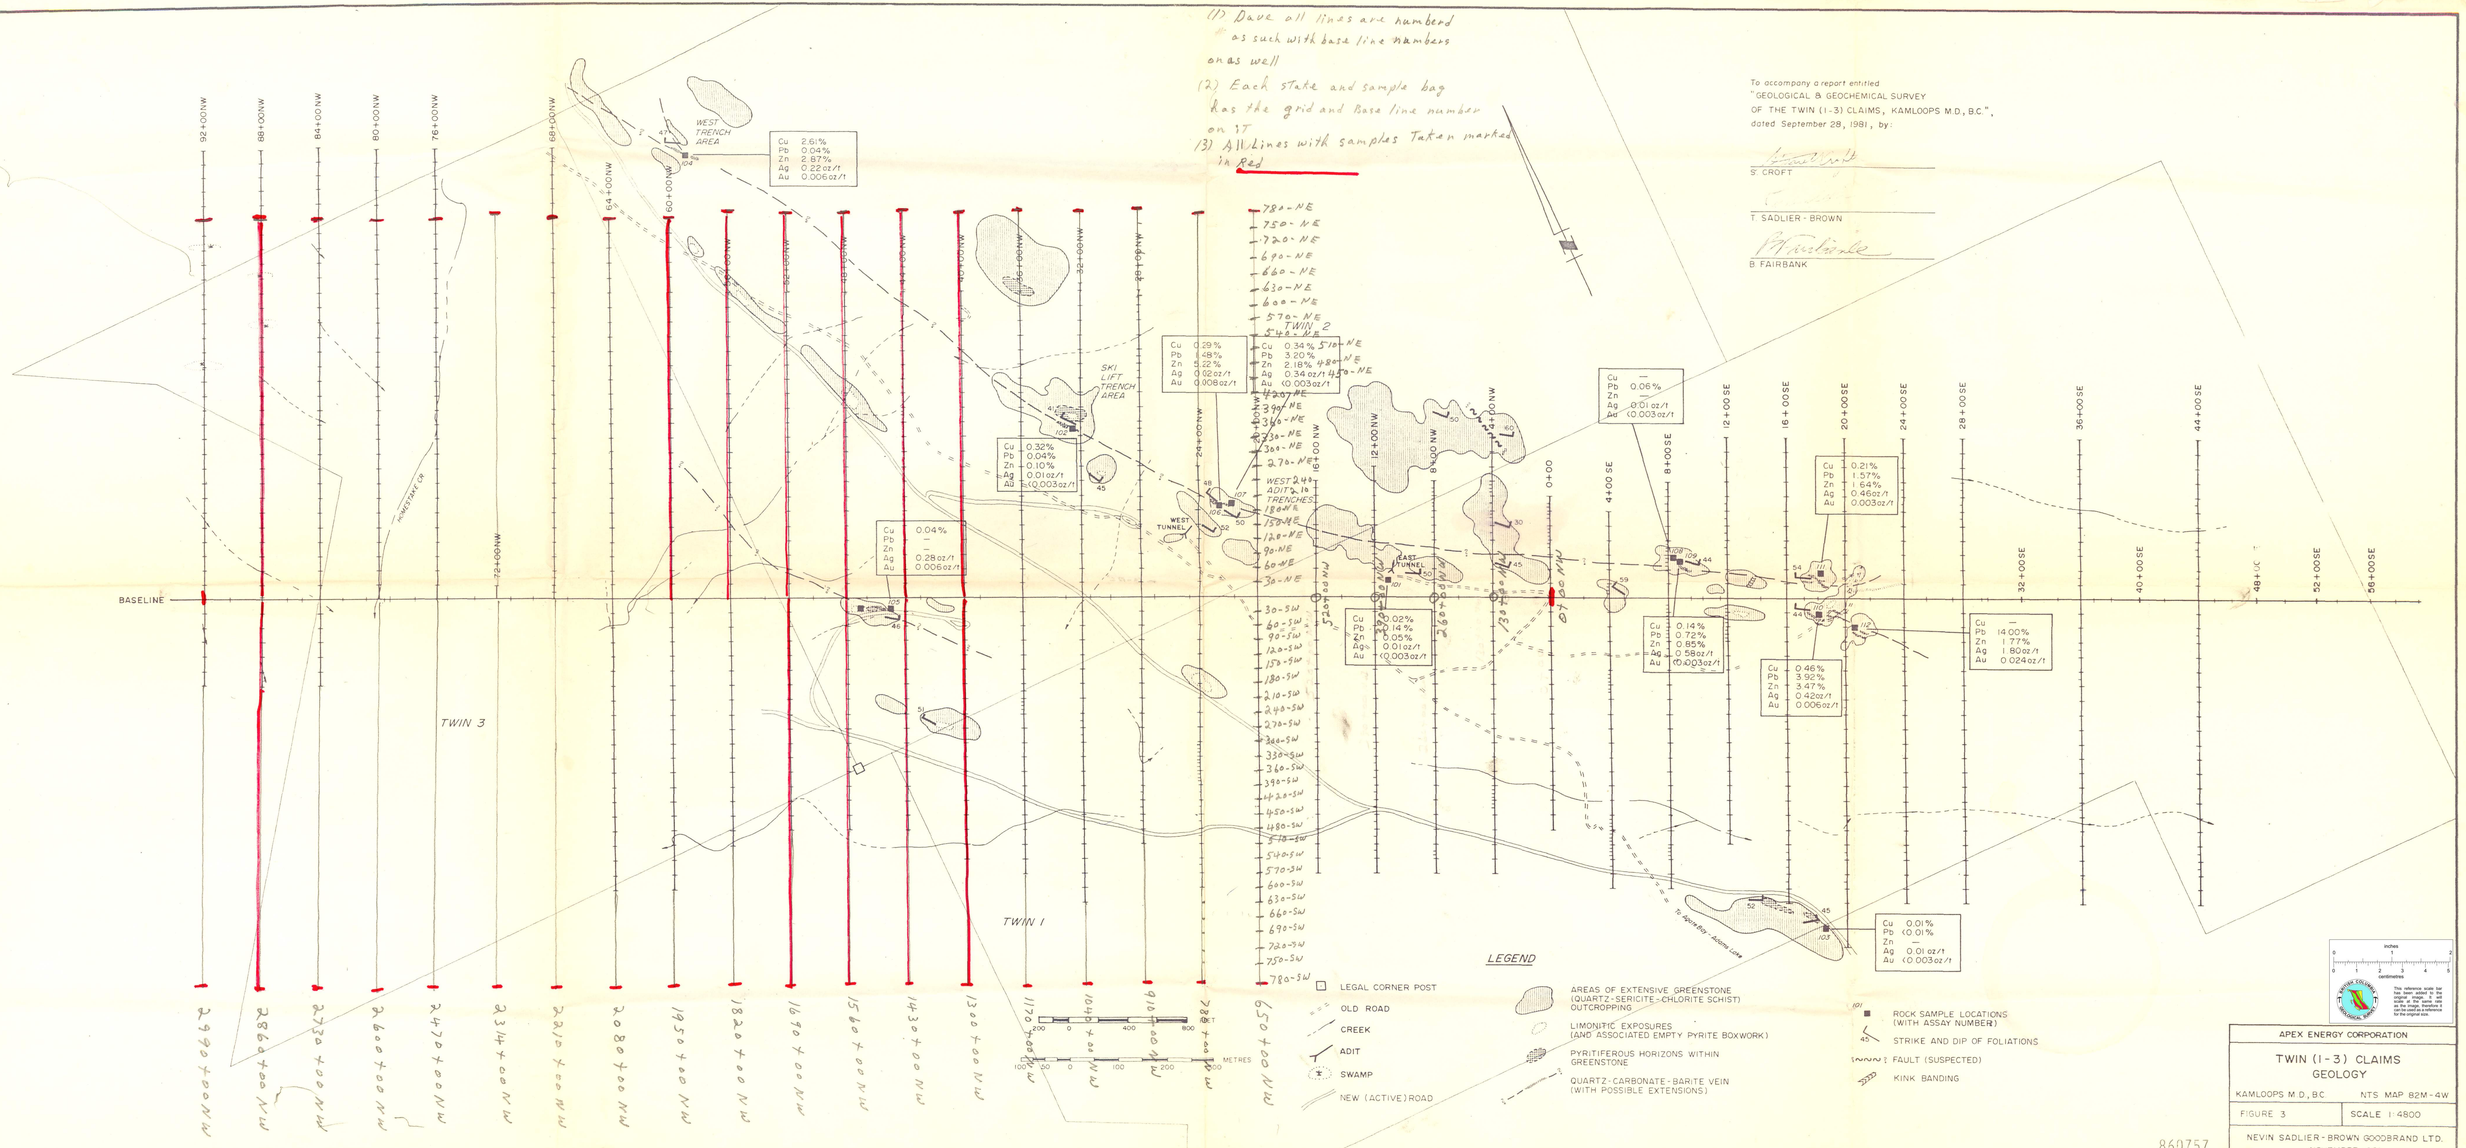


APEX ENERGY CORPORATION

TWIN (1-3) CLAIMS
GEOLOGY

KAMLOOPS M.D., BC | NTS MAP 82M-4W

FIGURE 3 | SCALE 1:4800

NEVIN SADLIER-BROWN GOODBRAND LTD.
NOVEMBER 1981

860757