REVISED MINERAL INVENTORY MAP

82E/SW(MI)

THE GOVERNMENT DEPARTMENT OF
MINES AND PETROLEUM RESOURCES
PARLIAMENT BUILDINGS, VICTORIA, BRITISH COLUMBIA V8V 1X4

Data compiled from published and unpublished reports.

Accuracy of location:

- ● known within a radius of 1,000 feet
- ▲ 1,000 feet to 2 miles
- ■ not known within 2 miles

Location and name subject to revision. Data known to be incomplete.

Copies of this map may be obtained for $1.00 per sheet.
Orders for maps should specify the map sheet number and letter.
Orders should be addressed, with prepayment, to the

Department of Mines and Petroleum Resources,
Victoria, B. C. V8V 1X4

Mineral Inventory cards containing specific information on each of the following mineral occurrences are available for viewing in open file according to the map number. Contact the Resource Data Section, Geological Division, Victoria.

NO. 82E/SW-	NAME	PRODUCT (S)
1	DIVIDEND — LAKEVIEW	Au, Ag, Cu
2	HORN SILVER	Ag, Au, Cu, Pb, Zn
3	KING EDWARD (SUP, SUSAP, TOM)	Cu, Mo, Ag, Au
4	MAX SICCAR (BULLER, BOBS)	Au, Ag, Cu
5	TINHORN	Au
6	MORNING STAR	Au
7	STEMWINDER (FLORA)	Au
8	FAIRVIEW	Au, ~~S?~~
9	MO	Mo, ~~Pb~~
10	ORO FINO — INDEPENDENCE	Au
11	TWIN LAKES	Au
12	DOLPHIN	Cu, Ag
13	BULLION	Cu
14	GOLD VALLEY (SOMETHING GOOD)	Au
15	SUNRISE (REDLEY MONARCH)	Au
16	GOLCONDA	Cu, Mo, Au, Ag, Pb
17	DIEF	Mo, ~~Re~~, Jasper
18	FONTENOY	Ag
19	WATERLOO	Au
20	CARIBOO — AMELIA	Cu, Zn, Pb, Au, Ag
21	VICTORIA — OLD ENGLAND	Au
22	DAYTON	Au, Ag, Cu, ~~Pb~~
23	WAR EAGLE — LE ROI	Au, Ag, Cu
24	ANARCHIST	Cr
25	BELAIR	Cr
26	ROCK CREEK	~~Placer Au~~
27	JONES	~~Placer Au~~
28	JOE 7 (BLU)	Cu
29	CARMI	Au, Ag, Pb, Zn
30	BELL	Au, Ag, Pb, Zn, Cd
31	KOKOMO FR.	Ag, Pb
32	DUNCAN	Ag, Pb
33	BOUNTY	Ag, Pb, Zn
34	RAMBLER FR.	Ag, Pb, Zn, Au
35	STANDARD FR.	Ag, Pb, Zn
36	BUSTER	Ag, Pb, Zn
37	OLD 7	Cu, Mo
38	ROCCO PLATA (NEPANEE, COBALT)	Ag, Pb, Zn, Au, Cu
39	WASHINGTON — IDAHO	Ag, Au, Pb
40	BEAVER	Ag, Pb, Zn, Au
41	GOLD DROP	Ag, Pb, Zn, Ag ?
42	GOLD ZONE (SILVER BELL)	Ag, Au, Zn
43	GOLD HILL	Au, Pb, Zn
44	EUREKA	Au, Ag, Pb, Zn
45	SAILOR	Au, Pb, Zn
46	MINNIE — HA - HA	Au
47	APEX	Au, Cu, Ag
48	AUSTRALIAN	Au
49	PAPEX	Cu
50	KOPR	Cu
51	STAR OF HOPE, ECLIPSE	Au
52	GREENWOOD	?
53	LOOKOUT, MOUNTAIN VIEW	Au
54	OLD 12 (WALT 13)	Cu, Mo, Ag
55	OLD NICK	Ni
56	NORTHWESTERN QUARRIES	Stone
57	WHITE KNIGHT	Ag
58	MATT (MO)	Mo, Cu, Fl
59	DOLLAR (ONYO), ACKWORTH, ESTER)	Ag, Au
60	LYNX	Cu
61	ENTERPRISE, TERESA	Au
62	COSLY	Ag, Au
63	BOOMERANG, WS	Ag, Au
64	CROWN POINT	Ag, Pb, Zn
65	BLACK DIAMOND — STANDARD	Ag
66	BOUNTY FR.	Ag, Pb, Zn
67	TIGER (WABASH ?)	Ag, Pb, Zn
68	NODAWAY	Ag, Pb, Zn
69	CASTOR FR.	Ag, Pb, Au
70	HOMESTAKE FR.	Ag, Au, Pb, Zn
71	SCANDIE (SCANDIA, JAY)	Ag, Pb, Zn
72	WELLINGTON	Ag, Pb, Zn, Au
73	SALLY	Ag, Pb, Zn, Au
74	OPULENCE	Cu
75	LIBRA	Cu
76	ROHNE	Cu
77	SHELL 1	Cu, Ag, Pb, Zn
78	DUSTY MAC	Au, Ag
79	SHELL 17	Cu, Ag, Pb, Zn
80	LBF	Mo, Cu
81	GOATS, MONS	Ag, Au, Pb
82	MAG (LOUIS ?)	Mo
83	CHUKAR	Cu
84	GYPO (OLIVER SILICA, QUARRY)	Au, Ag, ~~Silica, Fluorite~~
85	OLALLA CREEK	Limestone
86	SILVER COIN	Cu
87	COPPER COIN	Cu
88	HOMESTEAD	Cu
89	SMUGGLER (POWIS)	Au
90	SUSIE	Au, Ag, Pb, Zn, Sb
91	STANDARD	Au, Ag, Pb, Zn
92	DIVINE	Au, Ag
93	EMPIRE (OLIVER)	Au, Ag
94	Bey (Lloyd, Dew)	Au, Ag
95	ACH — I — NOUK	Ag, Au
96	OLALLA	Ag, Au
97	QUEEN MARY	Ag, Au
98	YELLOW VALLEY	Ag, Au
99	LITTLE SIOUX	Cu
100	BOOT	Cu, Ag, Ni
101	FUR. I ((DOREN)	Cu, Pb, Zn, Au, Ag
102	FUR II ((DOREN)	Cu, Pb, Zn, Au, Ag
103	MAY	Ag, Pb
104	CAPCO	Cu, Ni
105	PA	W
106	BUCK	Nepheline syenite
107	PATRICIA	Cu
108	MARS (TORBES)	Au, Ag, Cu, Pb, Zn
109	LAURION	Pb, Zn
110	BOOMERANG (PEDRO, SUNSHINE)	Asbestos
111	PASS	Cu, Pb, Au, Ag
112	AJJ	Au, Ag
113	HILL	Au
114	JJ	Cu
115	WALLACE MTN	Fl
116	ROCK CREEK	Ab, ~~NEPHELINE~~
117	MOLKA	Cu
118	BALDY, RICE	Au, Ag, Cu
119	HOMESTAKE	Cu
120	CORO	Ni, Cu
121	BAY	Ni, Cu
122	GIL	Mo, Cu
123	RENO	Au, Ag, Nb?
124	DIVIDEND	Cu
125	NIKKE	Cu, Pb, Zn, Ag
126	YOUNKEN, MCKINNEY	Mo
127	SHUTTLEWORTH CREEK	Nb
128	GOLD STANDARD (W2)	Pb, Au
129	OGOPAN	Cu, Zn, Ag, Au
130	BLE 19 (OLD 18)	Cu, Ag, Mo, Fe
131	WALT 32 (OLD 3)	Cu, Ag, Mo, Fe
132	BUTCHER BOY	Au, Ag, Pb, Zn
133	HIGHLAND LASS	Ag, Pb, Zn, Au
134	SHID	Cu, Mo, W, Pb
135	JUN	Cu, Zn
136	DOORN 10(ARGENTIA)	Au, Ag, Cu
137	MO	Rhodonite
138	FOR	Mo, Cu
139	SCINT	U
140	SPOTTED LAKE	Magnesium Sulphate
141	POLVO	Li
142	SPIRE	Cu, Mo, Ag, Au
143	GOLDEN OAKS	Au, Cu, W
144	EK	Si
145	HIGHLAND CHIEF	Ag
146	OCCURRENCE	Au, Pb, Zn
147	NIPPER (DALE)	Au, Ag
148	JO DANDY	Ag, Pb, Zn, Au
149	OCCURRENCE	Cr
150	SILVER STAR	Ag, Cu, Zn, Pb, Mo
151	GOLDEN GATE	Zn, Pb
152	OCCURRENCE	Au, Ag, Cpy, Pb, Zn
153	GORN (KEN)	Au, Ag, Cu
154	LARI	W, minor U
155	OCCURRENCE	Ta
156	HARD CASH	Ag, Au
157	CRANBERRY, TUZO	Au, Ag
158	FLORENCE, PAYMASTER	Ag, Au
159	JOLLY CREEK	Cr
160	KRUGER MT	Alkaline Rock
161	KEEMEOS	Rhodonite
162	MARCH FLAT	Ag
163	CAMPTON	Cu, Sc
164	FAIRVIEW	W?
165	ALLEN GROVE	Au
166	GREEN MOUNTAIN	Potash
167	OLIVER	Au
168	JAKE, GWEN	Mo, Cu, Au

delete 164

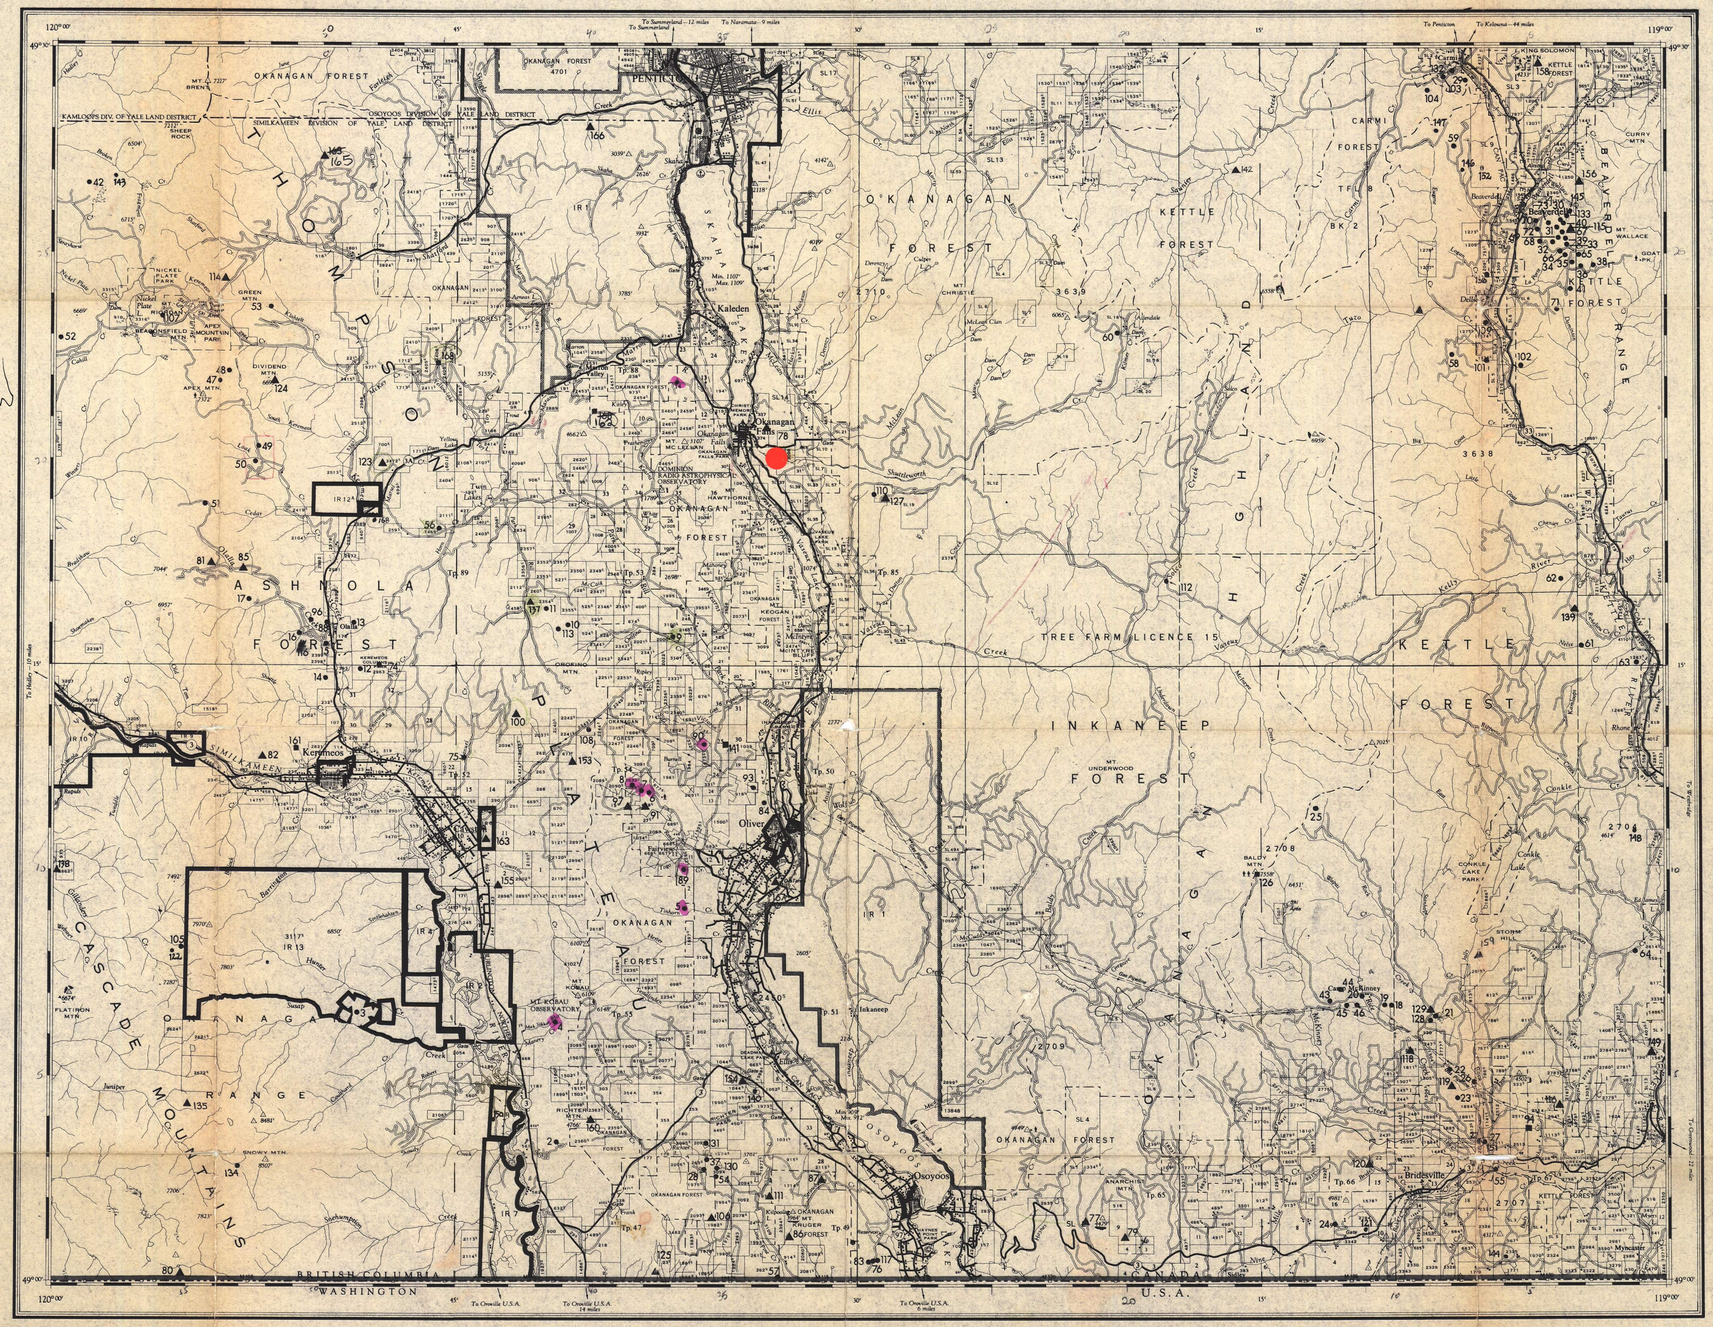
120°00'
49°30'
119°00'
49°00'
To Summerland—12 miles
To Summerland
To Naramata—9 miles
To Penticton
To Kelowna—44 miles
OKANAGAN FOREST
KAMLOOPS DIV. OF YALE LAND DISTRICT
OSOYOOS DIVISION OF YALE LAND DISTRICT
SIMILKAMEEN DIVISION OF YALE LAND DISTRICT
PENTICTON
Kaleden
Okanagan Falls
Kerrisdale
Oliver
Osoyoos
Bridesville
Beaverdell
Rock Creek
Midway
Greenwood
Westbridge
Carmi
Rock Creek
Anarchist
Mt. Kobau Observatory
Nickel Plate Park
Apex Mountain Park
Conkle Lake Park
Storm Hills
Snowy Mtn.
Flatiron Mtn.
Green Mtn.
Dividend Mtn.
Apex Mtn.
Sheep Rock
Mt. Brent
Mt. Christie
Mt. Underwood
Baldy Mtn.
Anarchist Mtn.
Curry Mtn.
Mt. Wallace
Goat Pk.
Okanagan Forest
Okanagan Forest 4701
Kettle Forest
Carmi Forest
